

MAR 21 1999

TIBER 19296PG606

SECTION

LAND CORNER RECORDATION CERTIFICATE
Filing Requirement of Act 74, Mich. P.A. 1970

For corners in

<u>Oakland</u> (County)	Located in: Lyon Township	Corner Code #
1. Public Land Survey	T <u>1N</u> R <u>7E</u>	<u>H-5</u>
	T _____ R _____	_____
	T _____ R _____	_____
	T _____ R _____	_____
2. Property Controlling in Section	S _____ T _____ R _____	_____
	S _____ T _____ R _____	_____
3. Miscellaneous Property in Sec.	S _____ T _____ R _____	_____
	S _____ T _____ R _____	_____
4. Lot No. _____, Recorded Plat _____		
5. Private Claims _____		

\$ 9.00 MISCELLANEOUS RECORDING
 \$ 2.00 REMONUMENTATION
 17 DEC 98 3:37 P.M. RECEIPT# 518
 PAID RECORDED - OAKLAND COUNTY
 G. WILLIAM CADDELL
 CLERK/REGISTER OF DEEDS

Compliance with
 ACT 345, P.A. 1990

APPROVED ON: 11-24-98 JS
 OAKLAND COUNTY REMONUMENTATION
 PEER GROUP COMMITTEE

Register of Deeds Stamp & File Number

I, Bruce Antcliff, in a field survey on June 2 19 98, do hereby certify that under requirements of P.A. 74 Michigan P.A. of 1970, the corner points mentioned in lines 1 and 2 above were in conformance with regulations and rules therefore as required in the current manual of survey instructions of the United States Department of the interior, Bureau of Land Management or by a decree of a Court of Law and/or that the corner points mentioned in lines 3, 4 and 5 above were in conformance with the rules of the Michigan Board of Land Surveyors or by a Decree of a Court of Law; established, re-established, monumented, re-monumented, recovered, found as expressed below:

NOTE: Not more than 4 corners, all in the same town and range, may be recorded on this certificate.

A. Description of original monument and accessories and/or subsequent restoration:

H-5	1816	Holmes	G.L.O.	Set Post
	1963	N/A	O.C.R.C. Section Ties	1/2" Pipe
	1984	Kostecke	Cert. Survey L. 8672 P. 293 & 295	Iron

(Continued on Back)

B. Description of corner evidence found and/or method applied in restoring or reestablishing corner:

H-5 Iron as called for in L.C.R.C.'s and certified surveys has been destroyed. Set temporary point using four remaining witnesses. Meas. East 2650.1' to I-5 Record is 2649.0' (+1.0') Meas. West 2654.2' to G-5 Record is 2655.4' (-1.0'). Moved temporary point 1.0' East to check record dist. Set rebar 32.96' North of rebar on South right-of-way of 12 Mile Road as called for in L.C.R.C. L.11751, P.007). This point is 3.0' South of the C/L of 12 Mile Road (gravel) running East and West on line of a tree row running South.

Measure East 2649.1' to I-5 (G.L.O. = 2648.25') (Kostecke Survey (1984) = 2648.95') (Boss Survey (1993) = 2648.88')
 Measure West 2655.2' to G-5 (G.L.O. = 2648.25') (Harcoon Sub. = 2655.41') (Kostecke Survey (1992) = 2655.37')

C. Description of monument for corner and accessories established to perpetuate locating the position of the corner:


H-5 Set a 5/8" x 24" rebar with brass cap stamped "Oakland County Remonumentation P.S. #25826."

- PK Nail & Oakland Co. Remonumentation Tag in SW Face 36" Oak N 45° W 30.88'
- PK Nail & Oakland Co. Remonumentation Tag in W Face 8" Basswood N 10° E 24.42'
- PK Nail & Oakland Co. Remonumentation Tag in NW Face Twin 6"-8" Walnut S 20° W 29.88'
- PK Nail & Oakland Co. Remonumentation Tag in SW Face 24" Hickory S 45° E 53.00'
- Fnd. Rebar South 32.96'

The selected location is accepted by the Contractor and is generally accepted by professional surveyors as the best available evidence of the position of the original corner.

Signed by Bruce Antcliff Date 12-10-98
 EARTH TECH

Surveyor's Michigan License No. 25826

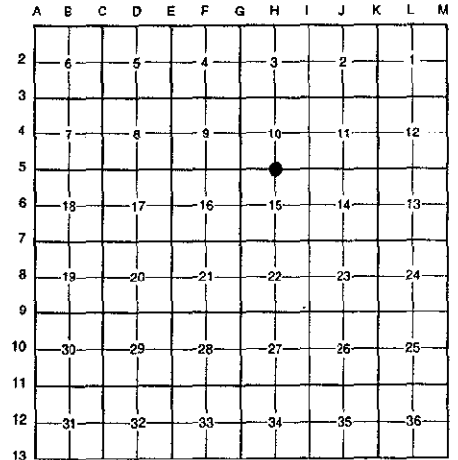

900 FILE
 200

MAR 11 1999

192960607

SECTION

A. Description of original monument and accessories and/or subsequent restoration:

H-5	1985	Kostecke	Survey	N/A
	1985	DeKeyser	Surveys	N/A
	1985	Kostecke	Survey	Iron
	1988	Kostecke	Harcoon Sub. L. 200 P. 1	N/A
	1990	Kohn	Witnesses L. 11751 P. 007-008	R.R. Spike
	1992	Kostecke	Cert. Survey L. 12786 P. 505	Pipe
	1993	Boss	Cert. Survey L. P.	N/A
	1993	G. Boss	Survey	R.R. Spike
	1994	Kostecke	Survey	Iron
	1995	Kostecke	Survey	Iron
	1995	GLA	Survey	N/A
	1995	Kostecke	Survey	N/A
	N/A	N/A	Lyon Twp. Witnesses	N/A
	N/A	N/A	O.C. Tax Maps	N/A