

MAR 27 1999

LIBER 19296 PG 610

LAND CORNER RECORDATION CERTIFICATE \$ 7.00 MISCELLANEOUS RECORDING \$ 2.00 REMONUMENTATION

Filing Requirement of Act 74, Mich. P.A. 1970

17 DEC 98 3:38 P.M. RECEIPT# 518 PAID RECORDED - OAKLAND COUNTY G. WILLIAM CADDELL CLERK/REGISTER OF DEEDS

Compliance with ACT 345, P.A. 1990

APPROVED ON 11-24-98 55 OAKLAND COUNTY REMONUMENTATION PEER GROUP COMMITTEE

Register of Deeds Stamp & File Number

DE 17 98 56 37 20

SECTION For corners in Oakland (County)

Located in: Lyon Township Corner Code #

- 1. Public Land Survey T 1N R 7E H-9
2. Property Controlling in Section S T R
3. Miscellaneous Property in Sec. S T R
4. Lot No. Recorded Plat
5. Private Claims

I, Bruce Antcliff, in a field survey on July 30 19 98, do hereby certify that under requirements of P.A. 74 Michigan P.A. of 1970, the corner points mentioned in lines 1 and 2 above were in conformance with regulations and rules therefore as required in the current manual of survey instructions of the United States Department of the interior, Bureau of Land Management or by a decree of a Court of Law and/or that the corner points mentioned in lines 3, 4 and 5 above were in conformance with the rules of the Michigan Board of Land Surveyors or by a Decree of a Court of Law; established, re-established, monumented, re-monumented, recovered, found as expressed below:

NOTE: Not more than 4 corners, all in the same town and range, may be recorded on this certificate.

- A. Description of original monument and accessories and/or subsequent restoration: 1816 Holmes G.L.O. Set Post 1980 G. Boss L.C.R.C. L. 7779 P. 222 PK Nail 1980 G. Boss Cert. Survey L. 7844 P. 87 N/A 1985 Thompson Cert. Survey L. 9210 P. 378 1/2" Pipe 1991 G. Boss Cert. Survey L. 11887 P. 289 N/A 1995 G. Boss Cert. Survey L. 16992 P. 328 N/A N/A N/A O.C. Tax Maps N/A

B. Description of corner evidence found and/or method applied in restoring or reestablishing corner:

H-9 Found a 1" iron in a monument box on the C/L of 10 Mile Road (bit.) running East and West on line of a tree row running South and a fence line running North. The found iron checks surveys and L.C.R.C.'s from 1980 to the present. Also checks the following witnesses:

L.C.R.C. L. 7779 P. 222 (1980) N 45° E 55.78' N. SE/S 24" Cherry (m. 55.58') South 48.70' N. W/S 12" Oak (m. 48.77') S 20° W 37.57' N. E/S 10" Oak (m. 37.48') Cert. Survey L. 9210 P. 378 (1985) North 31.07' to Nail W Side P.P. (m. 31.08') N 45° E 55.70' to Nail NW Side 24" Cherry (m. 55.58') S 30° W 37.55' to Nail E Side 15" Oak (m. 37.48')

Measure East 2629.8' to I-9 (Boss Survey (1995) = 2629.78') Measure West 2628.0' to G-9 (G.L.O. = 2639.34') (Boss Survey (1991) = 2628.00') (Smith Survey (1994) = 2628.09')

C. Description of monument for corner and accessories established to perpetuate locating the position of the corner:

H-9 Replaced 1" iron in a monument box with a 5/8" x 24" rebar with brass cap stamped "Oakland County Remonumentation P.S. #25826" in an existing monument box.


- PK Nail & Oakland Co. Remonumentation Tag in NW Side 24" Cherry N 45° E 55.58' PK Nail & Oakland Co. Remonumentation Tag in W Side 12" Oak South 48.77' PK Nail & Oakland Co. Remonumentation Tag in E Side 10" Oak S 20° W 37.48' PK Nail & Oakland Co. Remonumentation Tag in W Side P. Pole North 31.08'

The selected location is accepted by the Contractor and is generally accepted by professional surveyors as the best available evidence of the position of the original corner.

Signed by Bruce Antcliff Date 12-10-98

EARTH TECH

Surveyor's Michigan License No. 25826

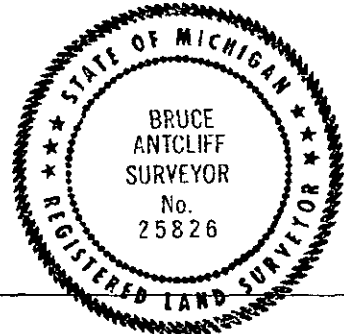

700 FILE