

MAR 11 1999

193510002

JA-599001696

SECTION

LAND CORNER RECORDATION CERTIFICATE
Filing Requirement of Act 74, Mich. P.A. 1970


For corners in

Table with columns: County (Oakland), Located in: Lyon Township, Corner Code # (H-13), and survey details (Public Land Survey, Property Controlling, etc.)

7.00 MISCELLANEOUS RECORDING
2.00 REMONUMENTATION
5 JAN 99 8:35 A.M. RECEIPT SA
PAID ... OAKLAND COUNTY
WILLIAM LAKE
Compliance with
ACT 345, P.A. 1990
APPROVED ON: 11-24-98 SS
OAKLAND COUNTY REMONUMENTATION
PEER GROUP COMMITTEE
Register of Deeds Stamp & File Number

- 4. Lot No. ... Recorded Plat
5. Private Claims

I, Bruce Antcliff, in a field survey on July 29 19 98, do hereby certify that under requirements of P.A. 74 Michigan P.A. of 1970, the corner points mentioned in lines 1 and 2 above were in conformance with regulations and rules therefore as required in the current manual of survey instructions of the United States Department of the interior, Bureau of Land Management or by a decree of a Court of Law and/or that the corner points mentioned in lines 3, 4 and 5 above were in conformance with the rules of the Michigan Board of Land Surveyors or by a Decree of a Court of Law; established, re-established, monumented, re-monumented, recovered, found as expressed below:

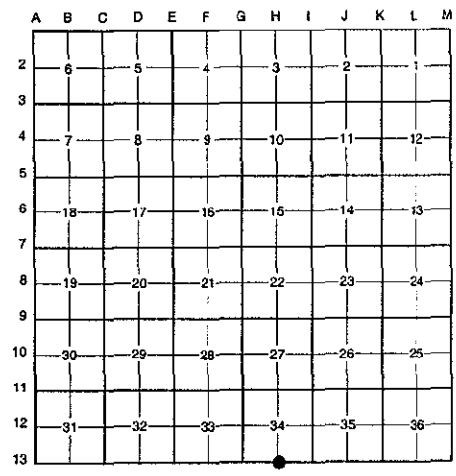

NOTE: Not more than 4 corners, all in the same town and range, may be recorded on this certificate.

A. Description of original monument and accessories and/or subsequent restoration:

H-13 1816 Holmes G.L.O. Set Post
N/A N/A O.C. Tax Maps N/A

No other information is available for this corner.

Records indicate this corner is not common with H-1, T1S, R7E

B. Description of corner evidence found and/or method applied in restoring or reestablishing corner:

H-13 Found a PK nail on the C/L of 8 Mile Road (bit.) running East and West on line of an old tree row and fence line running North. Measure East 300.30' to an iron pipe at H-1, T1S, R6E. The found PK nail is at the midpoint between G-13 and I-13 and 0.39' North of straight line between G-13 and I-13. No witnesses were available for this corner. Accepted the location of the PK for H-13.

Measure East 2620.34' to I-13 (G.L.O. = 2640.0')
Measure West 2620.28' to G-13 (G.L.O. = 2640.0')
Measure East 300.30' to H-1, T1S, R7E

7.00 FILE
2.00

C. Description of monument for corner and accessories established to perpetuate locating the position of the corner:

H-13 Replaced PK nail with a 5/8" x 24" rebar with brass cap stamped "Oakland County Remonumentation P.S. #25826." Also set a new monument box.

- PK Nail & Oakland Co. Remonumentation Tag in W Side P. Pole N 02° E 31.58'
PK Nail & Oakland Co. Remonumentation Tag in NW Side P. Pole N 77° E 154.26'
PK Nail & Oakland Co. Remonumentation Tag in SW Side 6" Pine S 75° E 122.23'
PK Nail & Oakland Co. Remonumentation Tag in NW Side 5" Cherry S 53° W 104.13'

The selected location is accepted by the Contractor and is generally accepted by professional surveyors as the best available evidence of the position of the original corner.

Signed by Bruce Antcliff Date 12-24-98
EARTH TECH
Surveyor's Michigan License No. 25826

