


LAND CORNER RECORDATION CERTIFICATE
Filing Requirement of Act 74, Mich. P.A. 1970

For corners in

Form with fields for Oakland SECTION (County), Located in: Lyon Township, Corner Code #, and numbered sections 1-5 for Public Land Survey, Property Controlling, Miscellaneous, Lot No., and Private Claims.

\$ 7.00 MISCELLANEOUS RECORDING
\$ 2.00 REMONUMENTATION
17 DEC 98 3:38 P.M. RECEIPT# 518
PAID RECORDED - OAKLAND COUNTY
G. WILLIAM CADDELL
CLERK/REGISTER OF DEEDS
ACT 345, P.A. 1990
APPROVED ON: 11-24-98 JS
OAKLAND COUNTY REMONUMENTATION
PEER GROUP COMMITTEE
Register of Deeds Stamp & File Number

17983122

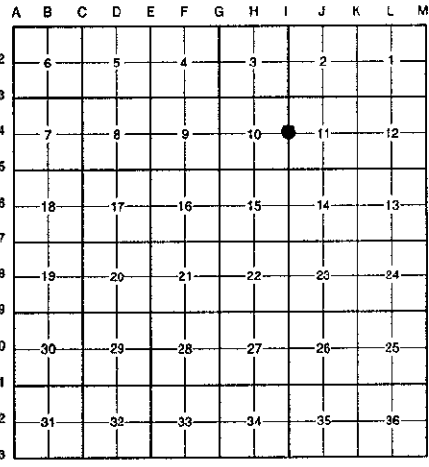

I, Bruce Antcliff, in a field survey on June 3 19 98, do hereby certify that under requirements of P.A. 74 Michigan P.A. of 1970, the corner points mentioned in lines 1 and 2 above were in conformance with regulations and rules therefore as required in the current manual of survey instructions of the United States Department of the Interior, Bureau of Land Management or by a decree of a Court of Law and/or that the corner points mentioned in lines 3, 4 and 5 above were in conformance with the rules of the Michigan Board of Land Surveyors or by a Decree of a Court of Law; established, re-established, monumented, re-monumented, recovered, found as expressed below:

NOTE: Not more than 4 corners, all in the same town and range, may be recorded on this certificate.

A. Description of original monument and accessories and/or subsequent restoration:

Table with 4 columns: Corner Code, Name, Description, and Method. Rows include 1816 Holmes G.L.O. Set Post, 1963 N/A O.C.R.C. Sec. Cor. Ties N/A, 1993 G. Boss Survey N/A, 1993 G. Boss Survey N/A, 1990 Kohn L.C.R.C. L. 12129 P. 040-041 Set 1/2" Rerod, N/A N/A O.C. Tax Maps N/A.

B. Description of corner evidence found and/or method applied in restoring or reestablishing corner:

I-4 Found a capped rebar 3.5' East of the C/L of South Hill Road (gravel) running North and South and 33' West of iron on East right-of-way. The found capped rebar checks surveys and L.C.R.C.'s from 1990 to the present. Also checks the following witnesses

- L.C.R.C. L. 12129 P. 040-041 (1990) West 23.22' N Face 6" cherry (m. 23.24') East 33.00' Pipe (m. 32.83')
Boss Survey (1993) East 32.9 3/4" Rod (m. 32.83') N 88° W 23.17 6" Cherry (m. 23.24') N 51° W 46.62 12" Elm (m. 46.38')


Measure North 2637.3' to I-3 (G.L.O. = 2640.0')
Measure South 2648.6' to I-5 (G.L.O. = 2640.0') (Boss Survey (1993) = 2648.57')

C. Description of monument for corner and accessories established to perpetuate locating the position of the corner:

I-4 Replaced capped rebar with a 5/8" x 24" rebar with brass cap stamped "Oakland County Remonumentation P.S. #25826."

- PK Nail & Oakland Co. Remonumentation Tag in N Side 6" W. Cherry West 23.24'
PK Nail & Oakland Co. Remonumentation Tag in SW 14" Basswood N 50° W 46.38'
PK Nail & Oakland Co. Remonumentation Tag in NW Side 12" White Oak N 35° E 37.10'
PK Nail & Oakland Co. Remonumentation Tag in S Side 12" White Oak East 19.93'
PK Nail & Oakland Co. Remonumentation Tag in NW Side 10" Elm S 30° W 37.86'
1/2" Rebar East 32.83'

The selected location is accepted by the Contractor and is generally accepted by professional surveyors as the best available evidence of the position of the original corner.

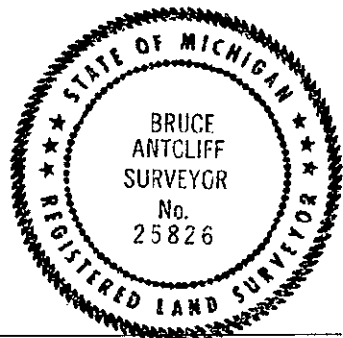

Signed by Bruce Antcliff Date 12-10-98
EARTH TECH
Surveyor's Michigan License No. 25826