

LIBER 19296PG614

LAND CORNER RECORDATION CERTIFICATE
Filing Requirement of Act 74, Mich. P.A. 1970


For corners in SECTION

Oakland (County) Located in: Lyon Township Corner Code #
1. Public Land Survey T 1N R 7E I-5
2. Property Controlling in Section S T R
3. Miscellaneous Property in Sec. S T R

\$ 9.00 MISCELLANEOUS RECORDING
\$ 2.00 REMONUMENTATION
17 DEC 98 3:38 P.M. RECEIPT# 518
PAID RECORDED - OAKLAND COUNTY
G. WILLIAM CADDELL
CLERK/REGISTER OF DEEDS
Compliance with ACT 345, P.A. 1990
APPROVED ON: 11-24-97 JS
OAKLAND COUNTY REMONUMENTATION PRER GROUP COMMITTEE
Register of Deeds Stamp & File Number

DE 1798363723

4. Lot No. Recorded Plat
5. Private Claims

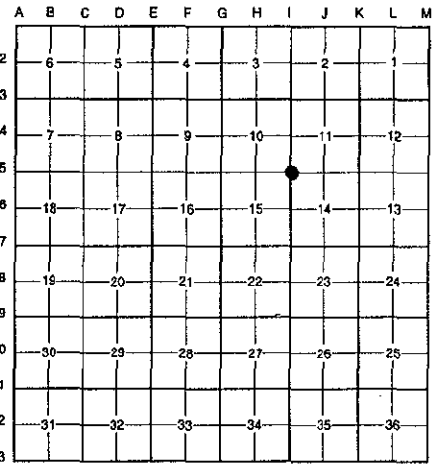

I, Bruce Antcliff, in a field survey on June 3, 1998, do hereby certify that under requirements of P.A. 74 Michigan P.A. of 1970, the corner points mentioned in lines 1 and 2 above were in conformance with regulations and rules therefore as required in the current manual of survey instructions of the United States Department of the interior, Bureau of Land Management or by a decree of a Court of Law and/or that the corner points mentioned in lines 3, 4 and 5 above were in conformance with the rules of the Michigan Board of Land Surveyors or by a Decree of a Court of Law; established, re-established, monumented, re-monumented, recovered, found as expressed below:

NOTE: Not more than 4 corners, all in the same town and range, may be recorded on this certificate.

A. Description of original monument and accessories and/or subsequent restoration:

I-5 1816 Holmes G.L.O. Set Post
1963 N/A O.C.R.C. Sec. Cor. Ties N/A
N/A N/A Lyon Twp. Witnesses Iron Pipe

(Continued on Back)

B. Description of corner evidence found and/or method applied in restoring or reestablishing corner:

I-5 Found a capped iron 3' West of the C/L of South Hill Road (gravel) running North and South and 6' ± South of the C/L of 12 Mile Road (gravel) running East and West. The found capped iron checks surveys and L.C.R.C.'s from 1974 to the present. Also checks closely with the 1934 O.C.R.C. witnesses:

Lyon Township Witnesses (1934) L.C.R.C. L. 11751 P. 007-008 (1991) Kostecke Boundary Survey (1995)
SW 75.25' 10" Butternut (m. 74.0') N 30° W 52.33' E Face 10" W. Pine (m. 52.21') SE 57.00' to 30" Maple (m. 56.97')
SE 56.75' 18" Maple (m. 56.97') S 30° W 74.00' E Face 18" Tree (m. 73.99') SW 74.10' to 24" Elm (63.99')
SE'ly 62.8' 18" Maple (m. 61.2')

Measure North 2648.6' to I-4 (G.L.O. = 2640.0') (Boss Survey (1993) = 2648.57')
Measure South 2640.3' to I-6 (G.L.O. = 2640.0') (O.C. Tax Maps = 2639'±) (O.C. Tax Maps = 2641.0')
Measure East 2663.3' to J-5 (G.L.O. = 2658.15')
Measure West 2648.85' to H-5 (G.L.O. = 2648.25') (Kostecke Survey (1984) = 2648.95') (Boss Survey (1993) = 2648.88')

5 W FILE
2 W

C. Description of monument for corner and accessories established to perpetuate locating the position of the corner:

I-5 Replaced capped iron with a 5/8" x 24" rebar with brass cap stamped "Oakland County Remonumentation P.S. #25826."


Nail in NE Side 16" Maple S 52° E 56.97'
PK Nail & Oakland Co. Remonumentation Tag in NE Side 10" Pine N 25° W 52.21'
PK Nail & Oakland Co. Remonumentation Tag in NW Side 8" Box Elder N 38° E 68.55'
PK Nail & Oakland Co. Remonumentation Tag in W Side 18" White Oak S 22° E 61.22'
PK Nail & Oakland Co. Remonumentation Tag in E Side 20" Walnut S 21° W 73.99'

The selected location is accepted by the Contractor and is generally accepted by professional surveyors as the best available evidence of the position of the original corner.

Signed by Bruce Antcliff Date 12-10-98

EARTH TECH

Surveyor's Michigan License No. 25826

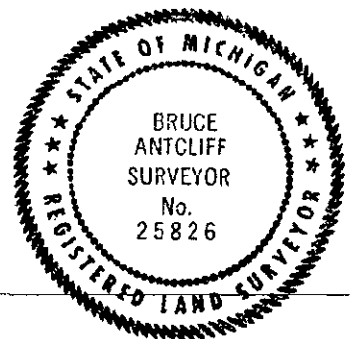

1933

LIBER 19296PG615

SECTION

A. Description of original monument and accessories and/or subsequent restoration:

I-5	1974	Kostecke	Plan of Survey L. 6373 P. 693	1/2" Rerod
	1982	Kostecke	Cert. Survey L. 8204 P. 199	N/A
	1984	Kostecke	Cert. Survey L. 8672 P. 293	1/2" Iron
	1985	Kostecke	Survey	1/2" Iron
	1990	Kohn	L.C.R.C. L. 11751 P. 008	1/2" Rerod
	1993	G. Boss	Survey	Capped Iron
	1993	G. Boss	Survey	N/A
	1994	Kostecke	Survey	N/A
	1995	Kostecke	Surveys	N/A
	N/A	N/A	O.C. Tax Maps	N/A