

LIBER 19296PG620

MAR 21 1998

LAND CORNER RECORDATION CERTIFICATE \$ 9.00 MISCELLANEOUS RECORDING  
Filing Requirement of Act 74, Mich. P.A. 1970 \$ 2.00 REMONUMENTATION

For corners in

| SECTION                               | Located in:             | Corner Code # |
|---------------------------------------|-------------------------|---------------|
| Oakland<br>(County)                   | Lyon<br>Township        |               |
| 1. Public Land Survey                 | T <u>1N</u> R <u>7E</u> | <u>J-3</u>    |
|                                       | T _____ R _____         | _____         |
|                                       | T _____ R _____         | _____         |
|                                       | T _____ R _____         | _____         |
| 2. Property Controlling<br>in Section | S _____ T _____ R _____ | _____         |
|                                       | S _____ T _____ R _____ | _____         |
| 3. Miscellaneous<br>Property in Sec.  | S _____ T _____ R _____ | _____         |
|                                       | S _____ T _____ R _____ | _____         |

17 DEC 98 3:39 P.M. RECEIPT# 518  
PAID RECORDED - OAKLAND COUNTY  
G. WILLIAM CADDELL  
CLERK/REGISTER OF DEEDS


Compliance with  
ACT 345, P.A. 1990

APPROVED ON: 11-29-98 JS  
OAKLAND COUNTY REMONUMENTATION  
PEER GROUP COMMITTEE  
Register of Deeds Stamp & File Number

1798363727

- 4. Lot No. \_\_\_\_\_, Recorded Plat \_\_\_\_\_
- 5. Private Claims \_\_\_\_\_

I, Bruce Antcliff, in a field survey on June 3 19 98, do hereby certify that under requirements of P.A. 74 Michigan P.A. of 1970, the corner points mentioned in lines 1 and 2 above were in conformance with regulations and rules therefore as required in the current manual of survey instructions of the United States Department of the interior, Bureau of Land Management or by a decree of a Court of Law and/or that the corner points mentioned in lines 3, 4 and 5 above were in conformance with the rules of the Michigan Board of Land Surveyors or by a Decree of a Court of Law; established, re-established, monumented, re-monumented, recovered, found as expressed below:

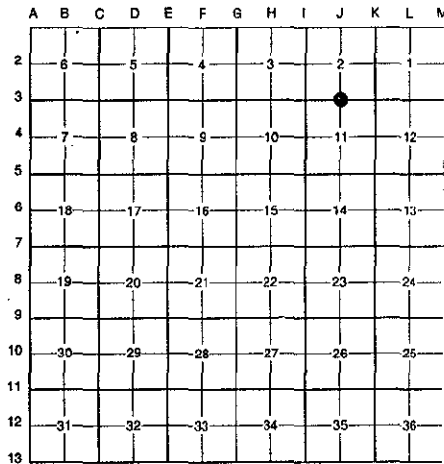

NOTE: Not more than 4 corners, all in the same town and range, may be recorded on this certificate.

A. Description of original monument and accessories and/or subsequent restoration:

| J-3 | 1816 | Holmes   | G.L.O.                         | Set Post         |
|-----|------|----------|--------------------------------|------------------|
|     | 1955 | Baynes   | Chas. T. Roby Sub. L. 82 P. 36 | N/A              |
|     | 1974 | Cantrell | L.C.R.C. L. 6324 P. 206        | 1 1/4" Iron Pipe |

(Continued on Back)

B. Description of corner evidence found and/or method applied in restoring or reestablishing corner:

J-3 Found a 1" iron pipe 14' East of the East edge of William K. Smith Drive (bit.) running North and 300' ± North of Grand River Avenue (bit.) running East and West. Checks location of iron at fence corner (running South and East) per L.C.R.C. L. 10504 P. 662 and L.C.R.C. L. 12129 P. 040-041. Also checks the following witnesses:

|                                                                    |                                               |
|--------------------------------------------------------------------|-----------------------------------------------|
| L.C.R.C. L. 10504 P. 667 (1988)                                    | L.C.R.C. L. 12129 P. 040-041 (1991)           |
| S 70° W 44.78' "4" Cut on Bolt NE Side D.E. Tower Base (m. 44.75') | S 70° W 44.78' NE Bolt Elec Tower (m. 44.75') |
| West 133.87' PK & Disc #22445 S Face 14" Elm (m. 133.76')          |                                               |
| S 20° E 5.21' PK & Disc #22445 W Face 6" Elm (m. 5.23')            |                                               |

500 FILE  
200

Measure East 2691.5' to K-3 (G.L.O. = 2679.6') (Boss Survey (1996) = 2687.83')  
Measure West 2723.2' to I-3 (G.L.O. = 2679.6')

C. Description of monument for corner and accessories established to perpetuate locating the position of the corner:


J-3 Replaced iron pipe with a 4" x 36" concrete monument with brass cap stamped "Oakland County Remonumentation P.S. #25826."

- PK Nail & Oakland Co. Remonumentation Tag in 14" Elm West 133.76'
- PK Nail & Oakland Co. Remonumentation Tag in 6" Elm S 20° E 5.23'
- NE Bolt Elec. Tower S 70° W 44.75'
- Capped Iron #29238 N 67° W 71.88'
- PK Nail & Oakland Co. Remonumentation Tag in E Edge of Bituminous Drive N 28° W 20.09'

The selected location is accepted by the Contractor and is generally accepted by professional surveyors as the best available evidence of the position of the original corner.

Signed by Bruce Antcliff Date 12-10-98  
EARTH TECH

Surveyor's Michigan License No. 25826

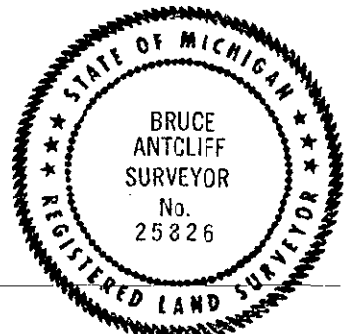

RECORD SECTION

MAR 22 1999

SECTION

LIBER 19296PG621

A. Description of original monument and accessories and/or subsequent restoration:

|     |      |          |                              |             |
|-----|------|----------|------------------------------|-------------|
| J-3 | 1978 | G. Boss  | L.C.R.C. L. 7338 P. 637      | 1" Pipe     |
|     | 1988 | Ward     | L.C.R.C. L. 10504 P. 667     | 1" Pipe     |
|     | 1988 | Ward     | Survey                       | 1" Pipe     |
|     | 1988 | Kostecke | Survey                       | N/A         |
|     | 1990 | Kohn     | L.C.R.C. L. 12129 P. 040-041 | Set 1" Pipe |
|     | 1996 | G. Boss  | Cert. Survey L. 16936 P. 206 | N/A         |
|     | N/A  | N/A      | O.C. Tax Maps                | N/A         |