

SECTION

LAND CORNER RECORDATION CERTIFICATE

Filing Requirement of Act 74, Mich. P.A. 1970

MISCELLANEOUS RECORDING \$2.00 REMONUMENTATION 5 JAN 99 8:30 A.M. RECEIPT# 8A PAID RECORDED - OAKLAND COUNTY G. WILLIAM CADDELL CLERK/REGISTER OF DEEDS Compliance with ACT 345, P.A. 1990 APPROVED ON: 12-16-98 SJ OAKLAND COUNTY REMONUMENTATION PEER GROUP COMMITTEE Register of Deeds Stamp & File Number


For corners in

Table with columns: Oakland (County), Located in: Lyon Township, Corner Code #. Rows include Public Land Survey, Property Controlling in Section, Miscellaneous Property in Sec.

4. Lot No. , Recorded Plat
5. Private Claims

I, Bruce Antcliff, in a field survey on August 4, 1998, do hereby certify that under requirements of P.A. 74 Michigan P.A. of 1970, the corner points mentioned in lines 1 and 2 above were in conformance with regulations and rules therefore as required in the current manual of survey instructions of the United States Department of the Interior, Bureau of Land Management or by a decree of a Court of Law and/or that the corner points mentioned in lines 3, 4 and 5 above were in conformance with the rules of the Michigan Board of Land Surveyors or by a Decree of a Court of Law; established, re-established, monumented, re-monumented, recovered, found as expressed below:

NOTE: Not more than 4 corners, all in the same town and range, may be recorded on this certificate.

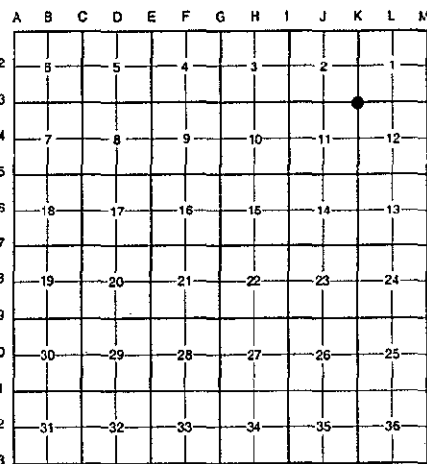

A. Description of original monument and accessories and/or subsequent restoration:

K-3 1816 Holmes G.L.O. Set Post
1963 N/A O.C.R.C. Sec. Cor. Ties Reinforcing Rod

(Continued on Back)

B. Description of corner evidence found and/or method applied in restoring or reestablishing corner:

K-3 Found a 3/4" iron pipe 1' West of the C/L of Old Plank Road (gravel) running North and South and 300' ± South of the south edge of bridge over I-96. The found iron pipe checks surveys and L.C.R.C.'s from 1978 to the present. Also checks the following witnesses:

L.C.R.C. L. 7338 P. 638 (1978) East 16.91' PK in Top Guard Rail Post (m. 16.94')
East 17.85' N Top of Guard Rail (m. 16.94') S 30° E 28.86' PK in Top Guard Rail Post (m. 28.87')
N 40° W 20.83' N Top of Guard Rail (m. 20.76') S 40° W 29.54' PK in Top Guard Rail Post (m. 29.48')
N 80° W 16.75' PK in Top Guard Rail Post (m. 15.69')
N 45° W 21.09' PK in Top Guard Rail Post (m. 21.08')

Measure North 2638.4' to K-2 (G.L.O. = 2640.0') (Boss Survey (1978) = 2638.87')
Measure South 2602.1' to K-4 (G.L.O. = 2640.0') (Miller Survey (1993) = 2602.17')
Measure East 2645.0' to L-3 (G.L.O. = 2651.55') (MDOT (1966) = 2650.0' ±)
Measure West 2691.5' to J-3 (G.L.O. = 2679.6') (Boss Survey (1978) = 2691.42') (Boss Survey (1996) = 2691.43')


G.W. FILE 200

C. Description of monument for corner and accessories established to perpetuate locating the position of the corner:

K-3 Replaced 3/4" iron pipe with a 5/8" x 24" rebar with brass cap stamped "Oakland County Remonumentation P.S. #25826."

PK Nail & Oakland Co. Remonumentation Tag in Top of Guard Rail Post East 16.94
PK Nail & Oakland Co. Remonumentation Tag in Top of Guard Rail Post S 30° E 28.87'
PK Nail & Oakland Co. Remonumentation Tag in Top of Guard Rail Post S 40° W 29.48'
PK Nail & Oakland Co. Remonumentation Tag in Top of Guard Rail Post N 80° W 15.69'
PK Nail & Oakland Co. Remonumentation Tag in Top of Guard Rail Post N 45° W 21.08'
PK Nail & Oakland Co. Remonumentation Tag in Top of Guard Rail Post N 40° E 31.98'

The selected location is accepted by the Contractor and is generally accepted by professional surveyors as the best available evidence of the position of the original corner.

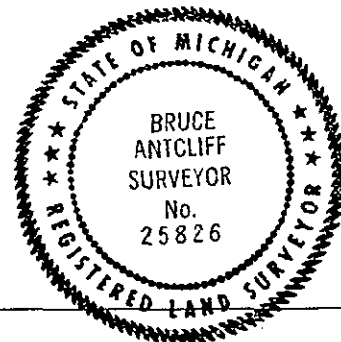

Signed by Bruce Antcliff

Date 12-22-98

EARTH TECH

Surveyor's Michigan License No. 25826

SECURITY  
RESTORATION

MAR 11 1999

LIBER 19351PC008

SECTION

A. Description of original monument and accessories and/or subsequent restoration:

K-3	1966	N/A	MDOT Highway Plans	N/A
	1978	Boss	Cert. Survey L. 7402 P. 01	N/A
	1978	Boss	L.C.R.C. L. 7338 P. 638	1/2" Pipe
	1979	Landini	Survey	N/A
	1993	Miller	Survey	3/4" Pipe
	1996	N/A	Cert. Survey L. 16936 P. 206	N/A
	N/A	N/A	O.C. Tax Maps	N/A