

1JA-599001703

LIBER 19351PG012

LAND CORNER RECORDATION CERTIFICATE
Filing Requirement of Act 74, Mich. P.A. 1970

SECTION

For corners in

<u>Oakland</u> (County)	Located in: Lyon Township	Corner Code #
1. Public Land Survey	T <u>1N</u> R <u>7E</u>	<u>K-6</u>
	T _____ R _____	_____
	T _____ R _____	_____
	T _____ R _____	_____
2. Property Controlling in Section	S _____ T _____ R _____	_____
	S _____ T _____ R _____	_____
3. Miscellaneous	S _____ T _____ R _____	_____
Property in Sec.	S _____ T _____ R _____	_____

\$ 7.00 MISCELLANEOUS RECORDING
 \$ 2.00 REMONUMENTATION
 5 JAN 99 8:30 A.M. RECEIPT# 8A
 PAID. RECORDED - OAKLAND COUNTY
 G. WILLIAM CADDELL
 CLERK/REGISTER OF DEEDS

Compliance with ACT 345, P.A. 1990

APPROVED ON: 11-24-98 JS
 OAKLAND COUNTY REMONUMENTATION
 PEER GROUP COMMITTEE

Register of Deeds Stamp & File Number

- 4. Lot No. _____, Recorded Plat _____
- 5. Private Claims _____

I, Bruce Antcliff, in a field survey on October 29 19 98, do hereby certify that under requirements of P.A. 74 Michigan P.A. of 1970, the corner points mentioned in lines 1 and 2 above were in conformance with regulations and rules therefore as required in the current manual of survey instructions of the United States Department of the interior, Bureau of Land Management or by a decree of a Court of Law and/or that the corner points mentioned in lines 3, 4 and 5 above were in conformance with the rules of the Michigan Board of Land Surveyors or by a Decree of a Court of Law; established, re-established, monumented, re-monumented, recovered, found as expressed below:


NOTE: Not more than 4 corners, all in the same town and range, may be recorded on this certificate.

A. Description of original monument and accessories and/or subsequent restoration:

K-6	1816	Holmes	G.L.O.	Set Post
	1989	G. Boss	Cert. Survey L. 11156 P. 249-250	Set 1/2" Iron
	N/A	N/A	O.C. Tax Maps	N/A

B. Description of corner evidence found and/or method applied in restoring or reestablishing corner:

K-6 This corner was established by G. Boss at the midpoint between K-5 and K-7 per Survey L. 11156 P. 249-250. Could not find iron set in Boss' survey. Reestablished corner at the midpoint. Set a 5/8" Reba on straight line between the Northwest and Southwest corners of Section 13. Reba is 5' + North of the C/L of a gravel road. This point falls in a gravel pit.

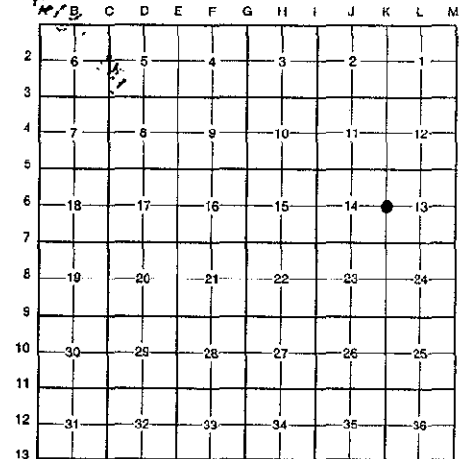

3.00 FILE
2.00

Measure North 2658.25' to K-5 (G.L.O. = 2640.0') (Boss Survey (1989) = 2652.67')
 Measure South 2658.25' to K-7 (G.L.O. = 2640.0') (Boss Survey (1989) = 2652.67')

C. Description of monument for corner and accessories established to perpetuate locating the position of the corner:

K-6 Replaced the capped rebar with a 5/8" x 24" rebar with brass cap stamped "Oakland County Remonumentation P.S. #25826."

- PK Nail & Oakland Co. Remonumentation Tag in N Side Fence Post N 89° W 1300.58'
- PK Nail & Oakland Co. Remonumentation Tag in S Side 3" Oak N 85° W 200.30'
- PK Nail & Oakland Co. Remonumentation Tag in N Side 12" Birch S 75° E 1003.33'
- Rerod 22' +/- South of Gravel Road S 45° E 71.30'
- Rerod 20' +/- South of Gravel Road S 45° W 83.28'
- Rerod 10' +/- North of Gravel Road N 65° E 71.81'

The selected location is accepted by the Contractor and is generally accepted by professional surveyors as the best available evidence of the position of the original corner.

Signed by Bruce Antcliff Date 12-24-98
 EARTH TECH

Surveyor's Michigan License No. 25826

