

SECTION

LAND CORNER RECORDATION CERTIFICATE
Filing Requirement of Act 74, Mich. P.A. 1970

For corners in

Table with columns: County (Oakland), Located in: Lyon Township, Corner Code #, and rows for Public Land Survey, Property Controlling in Section, Miscellaneous Property in Sec., Lot No., and Private Claims.

\$ 7.00 MISCELLANEOUS RECORDING
\$ 2.00 REMONUMENTATION
5 JAN 99 8:31 A.M. RECEIPT 8A
PAID RECORDED - OAKLAND COUNTY
G. WILLIAM CADWELL
CLERK/REGISTER OF DEEDS
Compliance with ACT 345, P.A., 1990
APPROVED ON: 11-24-98 55
OAKLAND COUNTY REMONUMENTATION PEER GROUP COMMITTEE
Register of Deeds Stamp & File Number

I, Bruce Antcliff, in a field survey on October 26 19 98, do hereby certify that under requirements of P.A. 74 Michigan P.A. of 1970, the corner points mentioned in lines 1 and 2 above were in conformance with regulations and rules therefore as required in the current manual of survey instructions of the United States Department of the interior, Bureau of Land Management or by a decree of a Court of Law and/or that the corner points mentioned in lines 3, 4 and 5 above were in conformance with the rules of the Michigan Board of Land Surveyors or by a Decree of a Court of Law; established, re-established, monumented, re-monumented, recovered, found as expressed below:

NOTE: Not more than 4 corners, all in the same town and range, may be recorded on this certificate.

A. Description of original monument and accessories and/or subsequent restoration:

Table with columns: Corner Code (M-7), Date (1816, 1974, 1988, N/A), Name (Holmes, Smith, Guaranty Surv. Survey, N/A), Description (G.L.O., Cert. Survey L. 6340 P. 236, O.C. Tax Maps), and Material (Set Post, Iron Pipe, N/A, N/A).

Records indicate this corner is not common with A-7, T1N, R8E

B. Description of corner evidence found and/or method applied in restoring or reestablishing corner:

M-7 Found a 1" iron pipe on the C/L of Natier Road (gravel) running North and South and 5' South of the C/L of 11 Mile Road (gravel) running West. The found 1" iron pipe checks 1650' North of the found iron on S/L of Guaranty survey of 1988. Also checks the following witnesses from 1974 survey:

Cert. Survey (1974)
NW 71.9' 10" Walnut (m. 71.86')

Measure North 2633.1' to M-6 (G.L.O. = 2640.0')
Measure South 2631.5' to M-8 (G.L.O. = 2640.0')
Measure West 2679.9' to L-7 (G.L.O. = 2673.66')

C. Description of monument for corner and accessories established to perpetuate locating the position of the corner:

M-7 Replaced 1" iron pipe with a 5/8" x 24" rebar with brass cap stamped "Oakland County Remonumentation P.S. #25826."


- List of monuments: PK Nail & Oakland Co. Remonumentation Tag in N Side Twin 12" & 18" Oak S 54° W 49.55', PK Nail & Oakland Co. Remonumentation Tag in S Side Wood Fence Cor. N 47° W 64.89', PK Nail & Oakland Co. Remonumentation Tag in W Side 15" Walnut N 18° W 71.86', PK Nail & Oakland Co. Remonumentation Tag in in N Side 12" Box Elder N 48° E 74.06', PK Nail & Oakland Co. Remonumentation Tag in E Side 12" Twin Cherry S 26° W 71.37', Stop Sign S 80° W 35.8'

The selected location is accepted by the Contractor and is generally accepted by professional surveyors as the best available evidence of the position of the original corner.

Signed by Bruce Antcliff Date 12-24-98

EARTH TECH

Surveyor's Michigan License No. 25826

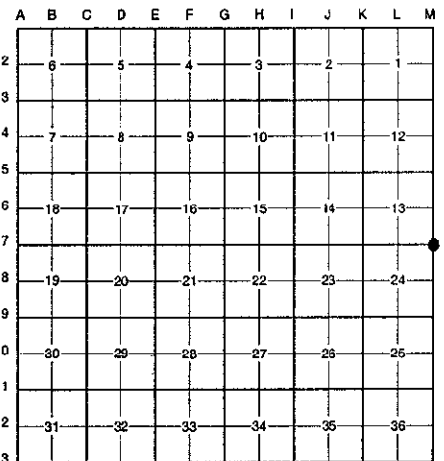

7.00 FILE
2.00

