

COPY

LIBER 168508409

LAND CORNER RECORDATION CERTIFICATE
Filing Requirement of Act 74, Mich. P.A. 1970

DEC 19 96 306301

For corners in

Table with columns: Oakland (county), Located In:, Corner Code #. Rows include Public Land Survey, Property Controlling in Section, and Miscellaneous Property in Sec.

\$ 7.00 MISCELLANEOUS RECORDING
\$ 2.00 REMONUMENTATION
19 DEC 96 11:00 A.M. RECEIPT# 178
PAID RECORDED - OAKLAND COUNTY
LYNN D. ALLEN, CLERK/REGISTER OF DEEDS

Compliance with
ACT 345, P.A. 1990


APPROVED ON: 9-11-96
OAKLAND COUNTY REMONUMENTATION
PEER GROUP COMMITTEE

Register of Deeds Stamp & File Number

4. Lot No. , Recorded Plat

5. Private Claims

I, Joseph C. Kapelczak, in a field survey on February 13, 1995, do hereby certify that under requirements of P.A. 74, Michigan P.A. of 1970, the corner points mentioned in lines 1 and 2 above were in conformance with regulations and rules therefore as required in the current manual of survey instructions of the United States Department of the Interior, Bureau of Land Management or by a decree of a Court of Law and/or that the corner points mentioned in lines 3, 4 and 5 above were in conformance with the rules of the Michigan Board of Land Surveyors or by a Decree of a Court of Law; established, re-established, monumented, re-monumented, recovered, found as expressed below:

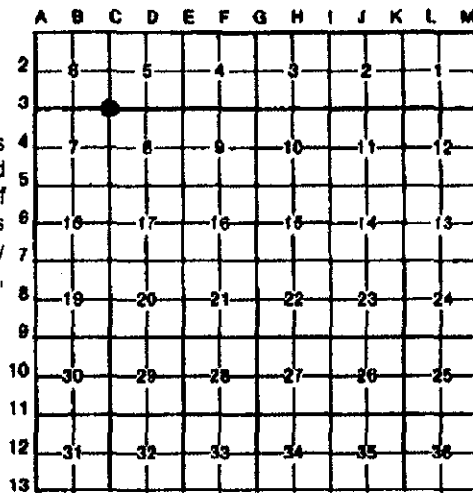

NOTE: Not more than 4 corners, all in the same town and range, may be recorded on this certificate.

A. Description of original monument and accessories and/or subsequent restoration:

Post set in 1816 G.L.O. Survey S 73 E 22 lks 24" Lyn S 80 W 15 lks 23" Lynwood
LCRC L.10041 P. 548 Butterfield 1987
1" Iron Bar in Monument Box
S 58 E 83.76' PK nail in utility pole
N 53 W 76.55' southeast bolt metal signal pole
S 58 W 75.15 east bolt metal light pole
N 74 E 101.34' PK nail in utility pole
LCRC L.10744 P. 567 Sandomierski, 1988
1" rod in Monument Box
N 74-33' E 101.39' PK south side utility pole
S 55 04' E 83.78 PK nail southwest side utility pole
S 51 59' W 75.37' center northeast bolt base light pole
N 54 46' W 76.59 center southeast bolt signal light pole

B. Description of corner evidence found and/or method applied in restoring or reestablishing corner:
Recovered R.R. spike in Monument Box centerline Wixom & centerline West Roads

Recovered witnesses:

N 74 E 101.39' PK nail south side MBT pole
S 54 E 83.91' PK nail southwest side MBT pole
N 59 E 89.81' 1/2" rered southwest corner Parcel #22-05-300-010


SURVEY &
REMONUMENTATION

MAY 22 1997

COMMISSION

C. Description of monument for corner and accessories established to perpetuate locating the position of the corner:
Set Remonumentation brass cap

Witnesses set
N 30 E 155.31' set nail w/remon tag southeast side power pole
N 74 E 101.27' set nail w/remon tag south side MBT pole
S 67 E 86.59' set nail w/remon tag northeast side power pole
S 46 E 140.71' set nail w/remon tag southwest side 14" locust

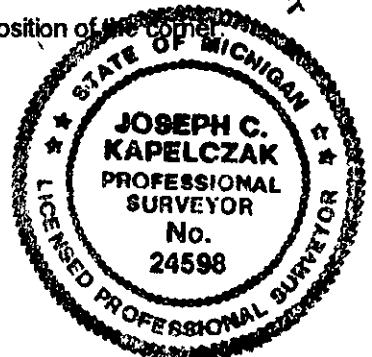

Signed by Joseph C. Kapelczak
Surveyor's Michigan License No. 24598

Date 8/8/96