

COPY

LIBR 168508413

Dec 1996 306305

LAND CORNER RECORDATION CERTIFICATE
Filing Requirement of Act 74, Mich. P.A. 1970

For corners in

<u>Oakland</u> (county)	Located in:	Corner Code #
1. Public Land Survey	T1N R8E	D-5
	T R	
	T R	
	T R	
2. Property Controlling in Section	S T R	
	S T R	
3. Miscellaneous Property in Sec.	S T R	
	S T R	


\$ 7.00 MISCELLANEOUS RECORDING
 \$ 2.00 REMONUMENTATION
 19 DEC 96 11:00 A.M. RECEIPT# 178
 PAID RECORDED - OAKLAND COUNTY
 LYNN D. ALLEN, CLERK/REGISTER OF DEEDS

Compliance with
 ACT 345, P.A. 1990
 APPROVED ON: 9-11-96
 OAKLAND COUNTY REMONUMENTATION
 PEER GROUP COMMITTEE

Register of Deeds Stamp & File Number

4. Lot No. _____, Recorded Plat _____
 5. Private Claims _____

I, Joseph C. Kapelczak, in a field survey on February 17, 1995, do hereby certify that under requirements of P.A. 74, Michigan P.A. of 1970, the corner points mentioned in lines 1 and 2 above were in conformance with regulations and rules therefore as required in the current manual of survey instructions of the United States Department of the Interior, Bureau of Land Management or by a decree of a Court of Law and/or that the corner points mentioned in lines 3, 4 and 5 above were in conformance with the rules of the Michigan Board of Land Surveyors or by a Decree of a Court of Law; established, re-established, monumented, re-monumented, recovered, found as expressed below:

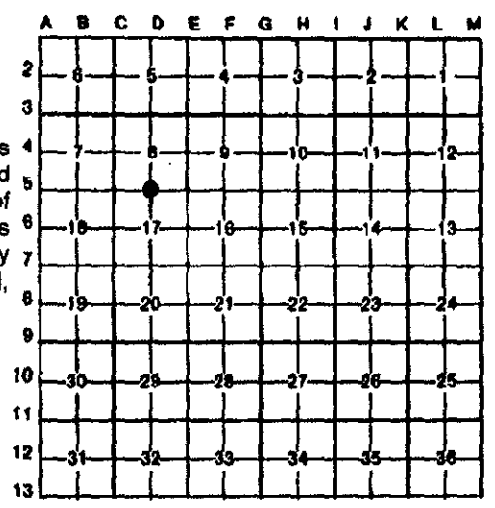

NOTE: Not more than 4 corners, all in the same town and range, may be recorded on this certificate.

A. Description of original monument and accessories and/or subsequent restoration:

Post set in 1816 G.L.O. survey. (No witness.)
 LCRC Vaderna, 1988 L. 10755 P.038
 Replaced PK nail with 1-1/4" x 30" Iron Pipe
 N 33.00' 1-1/4" Iron Pipe
 S 33.00' 1-1/4" Iron Pipe
 N 35 W 70.71' nail northeast side 8" Willow
 N 45 W 33.62' nail northeast side 6" Elm
 N 45 E 83.38' center M.H. rim
 (West 100.00' Iron in Monument Box)

B. Description of corner evidence found and/or method applied in restoring or reestablishing corner:
Recovered 1/2" rerod in 1-1/4" pipe centerline 12 Mile Road.

Recovered witnesses:

N 27 W 70.55 PK nail w/shiner northeast side 10" Willow
 N 27 W 69.63' PK nail south side 10" Willow
 N 19 W 22.68' Chisled "+" top of h/wall east end, north side road
 N 05 E 32.92' 1/2" rerod w/cap #24607 10057 southwest corner parcel #22-08-451-001
 N 05 E 58.28' 1/2" rerod cap #Arpee 10702
 N 80 E 161.86' fence corner
 S 07 W 112.38' PK nail w/shiner east side 8" Ash

C. Description of monument for corner and accessories established to perpetuate locating the position of the corner:

Set Remonumentation Brass Cap.

N 27 W 69.95' set nail w/remon tag northeast side 10" Willow
 N 19 W 22.68 Chisled "+" top east end h/wall north side road
 S 07 W 112.34' set nail w/remon tag east side 8" Ash
 N 80 E 161.96' Chisled "+" south side fence post

SURVEY & REMONUMENTATION

MAY 22 1997

JOSEPH C. KAPELCZAK

7.00 FILE
2.00



Signed by Joseph C. Kapelczak

Date 9/10/96

Surveyor's Michigan License No. 24598