

COPY

LIBER 16874PG130

LAND CORNER RECORDATION CERTIFICATE
Filing Requirement of Act 74, Mich. P.A. 1970

For corners in

Form with fields for Oakland (county), Located in, Corner Code #, and a table for Public Land Survey, Property Controlling in Section, and Miscellaneous Property in Sec.

\$ 9.00 MISCELLANEOUS RECORDING
3 JAN 97 7:49 A.M. RECEIPT# 88
PAID RECORDED - OAKLAND COUNTY
LYNN D. ALLEN, CLERK/REGISTER OF DEEDS
\$ 2.00 REMONUMENTATION

Compliance with
ACT 345, P.A. 1990

APPROVED ON: 12-4-96 TS
OAKLAND COUNTY REMONUMENTATION
PEER GROUP COMMITTEE

Register of Deeds Stamp & File Number

4. Lot No. Recorded Plat

5. Private Claims

I, Joseph C. Kapelozak, in a field survey on 22 January, 1996, do hereby certify that under requirements of P.A. 74, Michigan P.A. of 1970, the corner points mentioned in lines 1 and 2 above were in conformance with regulations and rules therefore as required in the current manual of survey instructions of the United States Department of the Interior, Bureau of Land Management or by a decree of a Court of Law and/or that the corner points mentioned in lines 3, 4 and 5 above were in conformance with the rules of the Michigan Board of Land Surveyors or by a Decree of a Court of Law; established, re-established, monumented, re-monumented, recovered, found as expressed below:

Grid table with columns A-M and rows 1-13. A dot is marked at the intersection of column D and row 7.

NOTE: Not more than 4 corners, all in the same town and range, may be recorded on this certificate.

A. Description of original monument and accessories and/or subsequent restoration:

Post set in 1816 G.L.O. S 75 W 16lks, 6" Elm; N 63 W 33lks, 5" Ash.

LCRC L6449 P210
Postiff 1974
3/4" pipe
\*N 00 E 33.06' 1" iron pipe
\*S 30 E 47.04' PK nail east face 14" Apple tree
S 60 E 73.66' PK nail west face 12" Apple tree

LCRC L11604 P648
Newman, 1986,
S 30 E 47.50' 14" Apple
S 60 E 73.66' 12" Apple
\*South 33.16' Fd. pipe
\*North 33.06' Fd. pipe

B. Description of corner evidence found and/or method applied in restoring or reestablishing corner:

Recovered 1" pipe in 22' gravel road

Recovered witnesses:

\*N 5 E 32.94' 1" pipe southwest corner parcel # 22-17-300-015
\*S 3 W 33.12' 1" pipe northwest corner parcel # 22-20-200-01
N 44 E 74.62' PK/shinner northwest side 8" Elm
N 44 E 74.64' Nail southeast side 8" Elm
\*S 24 E 47.17' PK/shinner west side 12" Apple
N 68 E 170.24' Nail tag #5390 northwest side power pole

\*confirms LCRC witness

C. Description of monument for corner and accessories established to perpetuate locating the position of the corner:

After new road construction set 5/8" rerod with O.C. remonumentation brass cap in monumnet box on centerline, 11 Mile Rd.

N 44 E 74.64' PK/remon tag northwest side 8" Elm
N 2 E 92.08' PK/remon tag east side power pole
N 68 E 170.38' PK/remon tag northwest side power pole
S 24 E 47.24' PK/remon tag west side 12" Apple

SURVEY &
REMONUMENTATION

MAY 22 1997

COMMISSION

Handwritten note: 9 20 FILE 2 20



Signed by Joseph C. Kapelozak

Date 12/3/96

Surveyor's Michigan License No. 24598

COPY

LIBER 16874 PG 160

JAN 397001306

LAND CORNER RECORDATION CERTIFICATE
Filing Requirement of Act 74, Mich. P.A. 1970

For corners in

Table with columns: Oakland (county), Located In:, Corner Code #. Rows include Public Land Survey, Property Controlling in Section, and Miscellaneous Property in Sec.

\$ 7.00 MISCELLANEOUS RECORDING
\$ 2.00 REMONUMENTATION
3 JAN 97 7:52 A.M. RECEIPT# 88
PAID RECORDED - OAKLAND COUNTY
LYNN D. ALLEN, CLERK/REGISTER OF DEEDS

Compliance with ACT 345, P.A. 1990


APPROVED ON: 12-4-96 TS
OAKLAND COUNTY REMONUMENTATION PEER GROUP COMMITTEE

Register of Deeds Stamp & File Number

4. Lot No. Recorded Plat

5. Private Claims

I, Joseph C. Kapelczak in a field survey on 22 January, 1996 do hereby certify that under requirements of P.A. 74, Michigan P.A. of 1970, the corner points mentioned in lines 1 and 2 above were in conformance with regulations and rules therefore as required in the current manual of survey instructions of the United States Department of the Interior, Bureau of Land Management or by a decree of a Court of Law and/or that the corner points mentioned in lines 3, 4 and 5 above were in conformance with the rules of the Michigan Board of Land Surveyors or by a Decree of a Court of Law; established, re-established, monumented, re-monumented, recovered, found as expressed below:

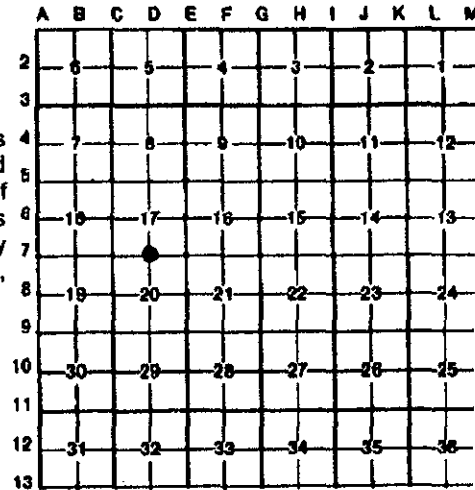

NOTE: Not more than 4 corners, all in the same town and range, may be recorded on this certificate.

A. Description of original monument and accessories and/or subsequent restoration: (Page 2)

LCRC L11545 P143
Milletics, 1989, iron pipe
\*North 32.92' Found iron pipe
S 30 E 47.53' Nail east 18" Apple
\*South 33.07' Found iron pipe
N 40 W 34.11' Nail southwest fence post

LCRC L11432 P168
Zeimet, 1990, Fd. 1 1/2" pipe (bent)
N 45 E 74.78' Nail south face 4" tree
S 50 E 79.16' Nail north face twin 8"/10" tree
S 25 E 47.39' Nail east face 12" Apple

B. Description of corner evidence found and/or method applied in restoring or reestablishing corner:

SURVEY & REMONUMENTATION

MAY 22 1997

COMMISSION

C. Description of monument for corner and accessories established to perpetuate locating the position of the corner:



Signed by Joseph C. Kapelczak
Surveyor's Michigan License No. 24598

Date 12/3/96

Handwritten note: 7.00 2.00