

COPY

LAND CORNER RECORDATION CERTIFICATE
Filing Requirement of Act 74, Mich. P.A. 1970

For corners in

Oakland (county)	Located In:	Corner Code #
1. Public Land Survey	T1N R 8E	E-11
	T___ R___	_____
	T___ R___	_____
	T___ R___	_____
2. Property Controlling in Section	S___ T___ R___	_____
	S___ T___ R___	_____
3. Miscellaneous Property in Sec.	S___ T___ R___	_____
	S___ T___ R___	_____

\$ 7.00 MISCELLANEOUS RECORDING
 \$ 2.00 REMONUMENTATION
 3 JAN 97 7:56 A.M. RECEIPT# 88
 PAID RECORDED - OAKLAND COUNTY
 LYNN D. ALLEN, CLERK/REGISTER OF DEEDS

Compliance with
 ACT 345, P.A. 1990
 APPROVED ON: 7-31-96 TMS
 OAKLAND COUNTY REMONUMENTATION
 PEER GROUP COMMITTEE
 Register of Deeds Stamp & File Number

4. Lot No. _____ Recorded Plat _____
 5. Private Claims _____

I, Joseph C. Kapelczak, in a field survey on 23 January, 1996, do hereby certify that under requirements of P.A. 74, Michigan P.A. of 1970, the corner points mentioned in lines 1 and 2 above were in conformance with regulations and rules therefore as required in the current manual of survey instructions of the United States Department of the Interior, Bureau of Land Management or by a decree of a Court of Law and/or that the corner points mentioned in lines 3, 4 and 5 above were in conformance with the rules of the Michigan Board of Land Surveyors or by a Decree of a Court of Law; established, re-established, monumented, re-monumented, recovered, found as expressed below:

NOTE: Not more than 4 corners, all in the same town and range, may be recorded on this certificate.

A. Description of original monument and accessories and/or subsequent restoration:

Post set in 1816 G.L.O. survey: S 86 E 11ks, 8" Beech; N 40 W 24ks, 14" Sugar.	LCRC L6257 P386
LCRC L6028 P637	Oliver, 1973, iron bar
Fouty, 1972, 1/2" pipe	S 66 E 58.70' 17" Walnut
Northeast 46.78' Consumers Power Co. marker	N 55 W 36.80' Utility pole
Southeast 58.71' Set nail north side 20" Elder	N 50 E 46.80' 3" CP. marker
Southwest 39.98' Anchor post	S 58 W 45.00' 3" CP. marker

B. Description of corner evidence found and/or method applied in restoring or reestablishing corner:


Recovered 1/2" rerod in monument box at centerlines of 9 Mile & Beck Rds.

No witnesses were recovered.

C. Description of monument for corner and accessories established to perpetuate locating the position of the corner:

Set O.C. remonumentation brass cap on exsting 1/2" rerod.

N 50 E 45.29' PK/remon tag south side power pole w/light
 S 40 E 74.57' PK/remon tag northeast side power pole w/guy wire
 S 80 W 122.60' PK/remon tag north side telephone pole
 N 65 W 83.04' PK/remon tag southwest side 4" Ash
 N 50 E 84.86' 1/2" rerod in monument corner Autumn Park sub.

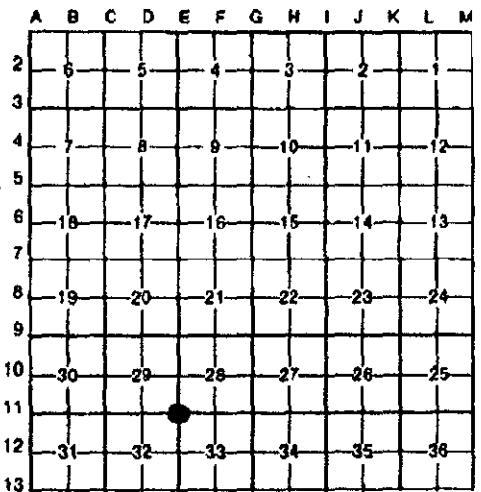

SURVEY & REMONUMENTATION

MAY 22 1997

COMMISSION



7.00
2.00
File

Signed by Joseph C. Kapelczak
 Surveyor's Michigan License No. 24598

Date 7/12/96