

COPY

LIBER 168740155

JAN 397001301

LAND CORNER RECORDATION CERTIFICATE
Filing Requirement of Act 74, Mich. P.A. 1970

For corners in

Table with columns: Oakland (county), Located In, Corner Code #. Rows include Public Land Survey, Property Controlling in Section, and Miscellaneous Property in Sec.

\$ 7.00 MISCELLANEOUS RECORDING
\$ 2.00 REMONUMENTATION
3 JAN 97 7:51 A.M. RECEIPT# 88
PAID RECORDED - OAKLAND COUNTY
LYNN D. ALLEN, CLERK/REGISTER OF DEEDS

Compliance with ACT 345, P.A. 1999
APPROVED ON: 12-4-96 FS
OAKLAND COUNTY REGISTER OF DEEDS

Register of Deeds Stamp & File Number


4. Lot No. , Recorded Plat

5. Private Claims

I, Joseph C. Kapelczak, in a field survey on 23 January 1996 do hereby certify that under requirements of P.A. 74, Michigan P.A. of 1970, the corner points mentioned in lines 1 and 2 above were in conformance with regulations and rules therefore as required in the current manual of survey instructions of the United States Department of the Interior, Bureau of Land Management or by a decree of a Court of Law and/or that the corner points mentioned in lines 3, 4 and 5 above were in conformance with the rules of the Michigan Board of Land Surveyors or by a Decree of a Court of Law, established, re-established, monumented, re-monumented, recovered, found as expressed below:

NOTE: Not more than 4 corners, all in the same town and range, may be recorded on this certificate.

A. Description of original monument and accessories and/or subsequent restoration:
Post set in 1816 G.O.L. survey: S 5 W 12lks, 10" Beech; N 74 W 17lks, 13" Beech.
LCRC L7088 P315
Fahrner 1977 Fd. Iron rod
N 10 E 31.55' S. West cor. Brick column
N 50 E 48.95' S. east cor. Brink column
*S 35 W 38.09' Nail in utility pole

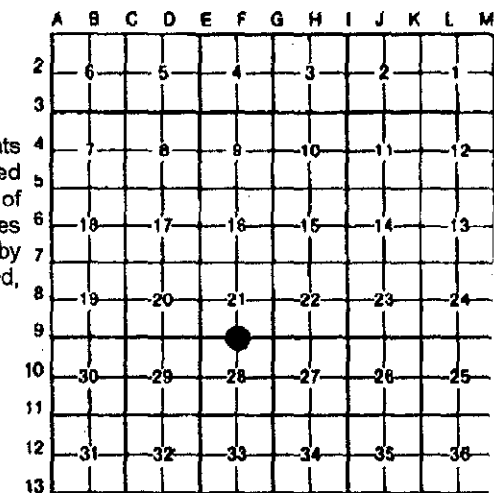

LCRC L7155 P645
Anderson 1977 Fd. Rerod
N 70 W 91.93' Nail east side power pole
N 50 E 69.44' Nail east side power pole
*S 45 W 38.10' Nail east side power pole

B. Description of corner evidence found and/or method applied in restoring or reestablishing corner:

Recovered 1/2" rerod (bent) in monument box on centerline 10 Mile Rd.

Recovered witnesses:

- S 06 W 32.86' 3/4" pipe northwest corner parcel #22-28-200-005
S 37 W 38.01' PK nail east side telephone pole
*S 37 W 38.03' Nail/tag #11495 east side telephone pole
N 66 W 92.31' PK nail south side power pole
N 68 E 69.21' PK nail southeast side power pole

*confirms LCRC witness

C. Description of monument for corner and accessories established to perpetuate locating the position of the corner:

Set 5/8" rerod with O.C. remonumentation brass cap.

- S 01 W 66.95' PK/remon tag east side 12" Poplar
S 66 E 128.10' Tip of arrow on fire hydrant
N 66 W 92.61' PK/remon tag south side power pole
N 68 E 69.23' PK/remon tag southeast power pole

SURVEY & REMONUMENTATION

MAY 22 1997

COMMISSION

7.00 FILE
2.00



Signed by Joseph C. Kapelczak
Surveyor's Michigan License No. 24598

Date 12/3/96