

# COPY

LIBER 16982 PG 808

FEB 12 97 035093

### LAND CORNER RECORDATION CERTIFICATE Filing Requirement of Act 74, Mich. P.A. 1970

For corners in

<u>Oakland</u> (county)	Located In:	Corner Code #
1. Public Land Survey	T <u>1N</u> R <u>8E</u>	<u>F-11</u>
	T _____ R _____	_____
	T _____ R _____	_____
	T _____ R _____	_____
2. Property Controlling in Section	S _____ T _____ R _____	_____
	S _____ T _____ R _____	_____
3. Miscellaneous Property in Sec.	S _____ T _____ R _____	_____
	S _____ T _____ R _____	_____

\$ 7.00 MISCELLANEOUS RECORDING  
 \$ 2.00 REMONUMENTATION  
 12 FEB 97 9:14 A.M. RECEIPT# 59A  
 PAID RECORDED - OAKLAND COUNTY  
 LYNN D. ALLEN, CLERK/REGISTER OF DEEDS

Compliance with  
 ACT 345, P.A. 1990

APPROVED ON: 12-9-96 RS  
 OAKLAND COUNTY REMONUMENTATION  
 PFR GROUP COMMITTEE

Register of Deeds Stamp & File Number

4. Lot No. \_\_\_\_\_, Recorded Plat \_\_\_\_\_

5. Private Claims \_\_\_\_\_

I, Joseph C. Kapelczak, in a field survey on 23 January, 1996, do hereby certify that under requirements of P.A. 74, Michigan P.A. of 1970, the corner points mentioned in lines 1 and 2 above were in conformance with regulations and rules therefore as required in the current manual of survey instructions of the United States Department of the Interior, Bureau of Land Management or by a decree of a Court of Law and/or that the corner points mentioned in lines 3, 4 and 5 above were in conformance with the rules of the Michigan Board of Land Surveyors or by a Decree of a Court of Law, established, re-established, monumented, re-monumented, recovered, found as expressed below:

	A	B	C	D	E	F	G	H	I	J	K	L	M
2	6		5		4		3		2		1		
3													
4	7		8		9		10		11		12		
5													
6	16		17		18		19		20		21		
7													
8	19		20		21		22		23		24		
9													
10	30		29		28		27		26		25		
11													
12	31		32		33		34		35		36		
13													

NOTE: Not more than 4 corners, all in the same town and range, may be recorded on this certificate.

A. Description of original monument and accessories and/or subsequent restoration:

Post set in 1816 G.L.O. survey: N 02 E 15ks, 9" Sugar; S 49 E 10ks, 12" Sugar.  
 LCRC L9919 P38 LCRC L9904 P462  
 Anderson, 1977, 1" iron pipe Kapelczak, 1984, 1/2" iron rod  
 Northeast 66.75' PK in 4" Elm \*S 70 W 65.85' Nail/tag north side power pole  
 Northwest 35.30' Nail/cap in M.B.T pole N 60 W 87.37' Nail/tag southwest side 12" Walnut  
 Southwest 65.54' Nail/cap in D.E. pole \*N 50 W 72.81' PK/tag southwest side guy pole  
 N 15 W 35.31' Nail/tag east side M.B.T. pole  
 N 05 W 54.04' PK/tag west side M.B.T. pole

\*confirms LCRC witness

B. Description of corner evidence found and/or method applied in restoring or reestablishing corner:

Recovered 1/2" rerod in monument box 7.00' south of centerline 9 Mile Rd.

Recovered witnesses:

\*S 80 W 65.78' PK/washer #24598 north side power pole  
 \*N 55 W 72.86' Nail/washer #5390 southwest side guy pole  
 N 10 W 54.29' Nail/washer # 5390 west side 12" Pine

SURVEY & REMONUMENTATION

MAY 22 1997


COMMISSION

700 FILE  
200

C. Description of monument for corner and accessories established to perpetuate locating the position of the corner:

Set O.C. remonumentation brass cap on existing 1/2" rerod.

N 50 W 72.70' PK/remon tag northeast side guy pole  
 N 05 W 54.25' PK/remon tag east side telephone pole  
 S 10 W 22.77' Chiseled cross on north rim sanitary manhole  
 S 80 W 65.65' PK/remon tag southeast power pole

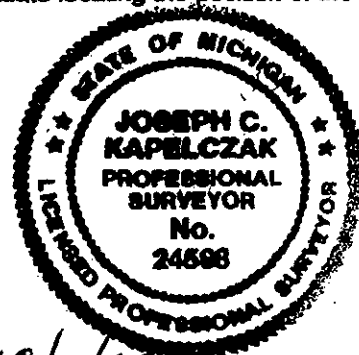

Signed by Joseph C. Kapelczak  
 Surveyor's Michigan License No. 24598

Date 12/11/96