

LIBER 16850 PG 420

COPY

LAND CORNER RECORDATION CERTIFICATE
Filing Requirement of Act 74, Mich. P.A. 1970

For corners in

<u>Oakland</u> (county)	Located in:	Corner Code #
1. Public Land Survey	T <u>1N</u> R <u>8E</u>	<u>G-1</u>
	T _____ R _____	_____
	T _____ R _____	_____
	T _____ R _____	_____
2. Property Controlling in Section	S _____ T _____ R _____	_____
	S _____ T _____ R _____	_____
3. Miscellaneous Property in Sec.	S _____ T _____ R _____	_____
	S _____ T _____ R _____	_____

\$ 7.00 MISCELLANEOUS RECORDING
 \$ 2.00 REMONUMENTATION
 19 DEC 96 11:02 A.M. RECEIPT# 178
 PAID RECORDED - OAKLAND COUNTY
 LYNN D. ALLEN, CLERK/REGISTER OF DEEDS

Commissioner of
 ACT 345, P.A. 1970
 APPROVED ON: 10-2-96
 OAKLAND COUNTY REMONUMENTATION
 PEER GROUP COMMITTEE
 Register of Deeds Stamp & File Number

4. Lot No. _____, Recorded Plat _____
 5. Private Claims _____

I, Joseph C. Kapelczak, in a field survey on 29 January, 1996, do hereby certify that under requirements of P.A. 74, Michigan P.A. of 1970, the corner points mentioned in lines 1 and 2 above were in conformance with regulations and rules therefore as required in the current manual of survey instructions of the United States Department of the Interior, Bureau of Land Management or by a decree of a Court of Law and/or that the corner points mentioned in lines 3, 4 and 5 above were in conformance with the rules of the Michigan Board of Land Surveyors or by a Decree of a Court of Law; established, re-established, monumented, re-monumented, recovered, found as expressed below:

	A	B	C	D	E	F	G	H	I	J	K	L	M
2	8		5			4		3		2		1	
3													
4	7		8			9		10		11		12	
5													
6	16		17			18		19		20		21	
7													
8	19		20			21		22		23		24	
9													
10	30		29			28		27		26		25	
11													
12	31		32			33		34		35		36	
13													

NOTE: Not more than 4 corners, all in the same town and range, may be recorded on this certificate.

A. Description of original monument and accessories and/or subsequent restoration:

Post set in 1816 G.L.O. survey: S 66-1/2E, 33 lks, 16" White Oak, S 32-1/2W 19 lks., 13" White Oak

LCRC L.6048 P.50 Stonerock, 1973
 Found 1" pipe in Monument Box
 N 10 E 28.09 PK nail in T pole
 N 45 E 51.80' PK nail in 15" Ash
 S 30 E 29.75 PK nail in guy pole

B. Description of corner evidence found and/or method applied in restoring or reestablishing corner:

Recovered PK nail broken. No Monument Box.

Recovered witnesses:

S 31 E 29.74' PK nail northeast side guy pole
 S 04 W 60.10' 1" pipe northwest corner Parcel #22-03-101-006
 N 22 E 27.97' PK nail west side light pole w/MBT
 S 86 E 321.88' 1/2" iron in Bit. Road

SURVEY &
 REMONUMENTATION

MAY 22 1997


COMMISSION

C. Description of monument for corner and accessories established to perpetuate locating the position of the corner:

Set Remonumentation Brass Cap and Monument Box.

S 05 W 56.49' set nail w/remon tag east side power pole
 N 22 E 28.21' set nail w/ remon tag west side light pole w/MBT
 N 01 W 37.15' set nail w/remon tag west side 15" Ash
 N 31 W 45.32' set nail w/remon tag southwest side 17" Ash

700 FILE
 200

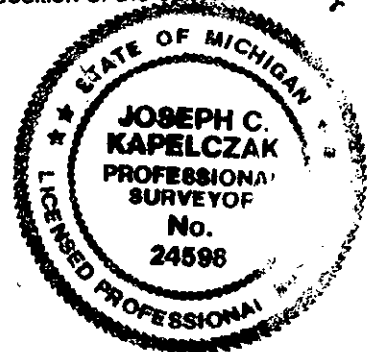

Signed by Joseph C. Kapelczak
 Surveyor's Michigan License No. 24598

Date 10/1/96