

LAND CORNER RECORDATION CERTIFICATE
Filing Requirement of Act 74, Mich. P.A. 1970

For corners in

\$ 7.00 MISCELLANEOUS RECORDING
\$ 2.00 REMONUMENTATION
19 JUL 95 2:02 P.M. RECEIPT# 71A
PAID RECORDED - OAKLAND COUNTY
LYNN D. ALLEN, CLERK/REGISTER OF DEEDS

Table with columns: Oakland (county), Located In:, Corner Code #. Rows include Public Land Survey, Property Controlling in Section, and Miscellaneous Property in Sec.

Compliance with ACT 345, P.A. 1990
APPROVED ON: 7-12-95 Tom S
OAKLAND COUNTY REMONUMENTATION PEER GROUP COMMITTEE
Register of Deeds Stamp & File Number

4. Lot No. _____, Recorded Plat

5. Private Claims

I, Joseph C. Kapelczak, in a field survey on February 16, 1995, do hereby certify that under requirements of P.A. 74, Michigan P.A. of 1970, the corner points mentioned in lines 1 and 2 above were in conformance with regulations and rules therefore as required in the current manual of survey instructions of the United States Department of the Interior, Bureau of Land Management or by a decree of a Court of Law and/or that the corner points mentioned in lines 3, 4 and 5 above were in conformance with the rules of the Michigan Board of Land Surveyors or by a Decree of a Court of Law, established, re-established, monumented, re-monumented, recovered, found as expressed below:

NOTE: Not more than 4 corners, all in the same town and range, may be recorded on this certificate.

A. Description of original monument and accessories and/or subsequent restoration:

- Post in 1816 G.O.L. survey; S 39 W 1lk, 6" Beech; S 57 E 18lks, 6" Ironwood.
LCRC L 7088 P 314 LCRC L 7155 P 654
Fahner 1977 Fd. 1/2" iron pipe Anderson 1978 Fd. nail in rd.
East 54.60' Utility pole nail N 15 W 33.03' Nail east side power pole
N 45 E 37.90' North end 12" cmp *East 54.69' Nail north side power pole
N 30 W 82.98' Utility pole flasher S 20 W 92.79' Nail southeast side 13" Poplar

B. Description of corner evidence found and/or method applied in restoring or reestablishing corner:

Recovered 1/2" rerod on centerline Taft Rd.

Recovered witnesses:


- *S 84 E 54.71' Nail w/#11495 north side telephone pole
S 84 E 54.59' PK nail south side telephone pole

*Confirms LCRC witness

C. Description of monument for corner and accessories established to perpetuate locating the position of the corner:

Set 5/8" rerod wiyh O.C. Remonumentation brass cap along with monument box replacing 1/2" rerod.

- S 84 W 54.65' PK/remon tag south side telephone pole
S 42 E 34.52' Tip of arrow on fire hydrant
N 81 W 67.81' PK/remon tag north side 8" dia. Elm
N 38 W 68.12' PK/remon tag northeast side power pole

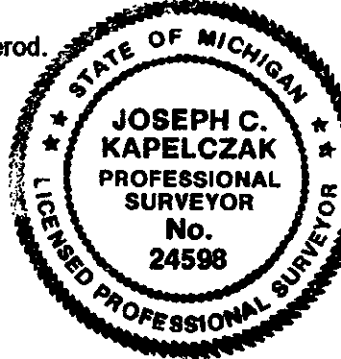

Signed by Joseph C. Kapelczak
Surveyor's Michigan License No. 24598

Date 6/28/95

7.00