

LAND CORNER RECORDATION CERTIFICATE
Filing Requirement of Act 74, Mich. P.A. 1970

For corners in

Oakland (county)	Located In:	Corner Code #
1. Public Land Survey	T1N R8E	G-13
	T R	
	T R	
	T R	
2. Property Controlling in Section	S T R	
	S T R	
3. Miscellaneous Property in Sec.	S T R	
	S T R	

\$ 7.00 MISCELLANEOUS RECORDING
 \$ 2.00 REMONUMENTATION
 19 JUL 95 2:03 P.M. RECEIPT# 71A
 PAID RECORDED - OAKLAND COUNTY
 LYNN D. ALLEN, CLERK/REGISTER OF DEEDS
 ACT 345, P.A. 1990
 APPROVED ON: 7-12-95 Tom S
 OAKLAND COUNTY REMONUMENTATION
 PEER GROUP COMMITTEE

Register of Deeds Stamp & File Number

4. Lot No. _____, Recorded Plat

5. Private Claims

I, Joseph C. Kapelczak, in a field survey on March 9, 1995, do hereby certify that under requirements of P.A. 74, Michigan P.A. of 1970, the corner points mentioned in lines 1 and 2 above were in conformance with regulations and rules therefore as required in the current manual of survey instructions of the United States Department of the Interior, Bureau of Land Management or by a decree of a Court of Law and/or that the corner points mentioned in lines 3, 4 and 5 above were in conformance with the rules of the Michigan Board of Land Surveyors or by a Decree of a Court of Law, established, re-established, monumented, re-monumented, recovered, found as expressed below:

NOTE: Not more than 4 corners, all in the same town and range, may be recorded on this certificate.

A. Description of original monument and accessories and/or subsequent restoration:
 Post set in 1815 G.O.L. survey by Alexander Holmes on Michigan baseline;
 N 31 E 361ks, 10" Beech; S 45 E 61ks, 6" Ironwood.

No LCRC's recorded

B. Description of corner evidence found and/or method applied in restoring or reestablishing corner:
 Recovered 1/2" rerod in monument box at 8 Mile & Taft Rds.


- Recovered witnesses:
- S 46 W 42.74' PK nail northwest side power pole
 - N 37 E 75.49' PK nail east side power pole
 - N 37 W 70.08' Nail & washer east side power pole
 - N 38 W 70.40' PK nail southwest side power pole
 - N 12 E 265.45' 1/2" rerod northwest corner parcel #22-34-351-020

C. Description of monument for corner and accessories established to perpetuate locating the position of the corner:
 Set 5/8" rerod with O.C. remonumentation brass cap replacing 1/2" rerod

- S 46 W 42.73' PK/remon tag northwest side power pole
- S 08 W 90.97' PK/remon tag west side power pole
- N 37 W 70.03' PK/remon tag east side power pole
- N 37 E 75.59' PK/remon tag east side power pole

	A	B	C	D	E	F	G	H	I	J	K	L
2	6	5	4	3	2	1						
3												
4	7	8	9	10	11	12						
5												
6	16	17	18	15	14	13						
7												
8	19	20	21	22	23	24						
9												
10	30	29	28	27	26	25						
11												
12	31	32	33	34	35	36						
13												

7.00
2.00
2.00

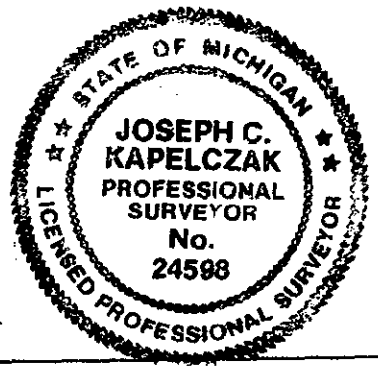

Signed by Joseph C. Kapelczak
 Surveyor's Michigan License No. 24598

Date 6/28/95