

LAND CORNER RECORDATION CERTIFICATE
Filing Requirement of Act 74, Mich. P.A. 1970

For corners in

Table with columns: Oakland (county), Located In, Corner Code #. Rows include Public Land Survey, Property Controlling in Section, and Miscellaneous Property in Sec.

\$ 7.00 MISCELLANEOUS RECORDING
\$ 2.00 REMONUMENTATION
19 DEC 96 11:03 A.M. RECEIPT# 178
PAID RECORDED - OAKLAND COUNTY
LYNN D. ALLEN, CLERK/REGISTER OF DEEDS

APPROVED ON: 10-2-96
OAKLAND COUNTY REMONUMENTATION
PEER GROUP COMMITTEE
Register of Deeds Stamp & File Number

4. Lot No. , Recorded Plat

5. Private Claims

I, Joseph C. Kapelczak, in a field survey on 29 January, 1996, do hereby certify that under requirements of P.A. 74, Michigan P.A. of 1970, the corner points mentioned in lines 1 and 2 above were in conformance with regulations and rules therefore as required in the current manual of survey instructions of the United States Department of the Interior, Bureau of Land Management or by a decree of a Court of Law and/or that the corner points mentioned in lines 3, 4 and 5 above were in conformance with the rules of the Michigan Board of Land Surveyors or by a Decree of a Court of Law; established, re-established, monumented, re-monumented, recovered, found as expressed below:

Grid table with columns A-M and rows 2-13. A dot is marked at the intersection of column G and row 3.

NOTE: Not more than 4 corners, all in the same town and range, may be recorded on this certificate.

A. Description of original monument and accessories and/or subsequent restoration:

Post set in 1816 G.L.O. survey: N 55 E 25 lks 9" Tamarac S 70 W 26 lks 7" Tamarac
L.C.R.C. L.8352 P.634, Kapelczak 1983
N 22.25' set nail w/washer east side 12" Maple
E 30.81' set nail w/washer south side 12" Maple
S 20 E 43.53' set nail w/washer east side base 26" base 4-10" Maples
W 22.52' set nail w/washer north side 10" Maple

B. Description of corner evidence found and/or method applied in restoring or reestablishing corner:

Recovered 1/2" rerod in 2" pipe (Bad ground.) No Monument Box.

Recovered witnesses:

S 80 W 22.89' PK nail w/washer #24598 north side 12" Maple
S 16 W 17.76' PK nail w/washer #24598 west side 8" Maple
N 42 W 25.31' PK nail w/washer #24598 northeast side 10" Maple
S 80 E 22.25' PK nail w/washer #24598 east side 12" Maple

C. Description of monument for corner and accessories established to perpetuate locating the position of the corner:

Set Remonumentation Brass Cap.


S 80 E 22.25' set nail w/remon tag north side 10" Maple
N 42 W 25.31' set nail w/remon tag northeast side 10" Maple
S 16 W 17.78' set nail w/remon tag west side 8" Maple
S 80 W 22.88 set nail w/remon tag east side 4-10" Maples

SURVEY &
REMONUMENTATION

MAY 22 1997

COMMISSION

7 00 FILE
2 00

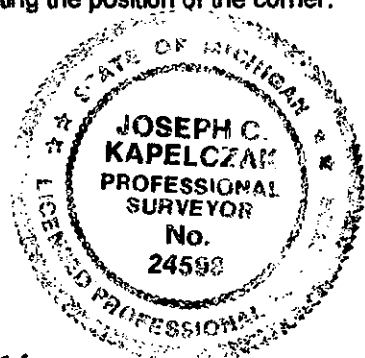

Signed by Joseph C. Kapelczak
Surveyor's Michigan License No. 24598

Date 10/1/96