

LIBER 15528pc766

LAND CORNER RECORDATION CERTIFICATE  
Filing Requirement of Act 74, Mich. P.A. 1970

\$ 7.00 MISCELLANEOUS RECORDING  
\$ 2.00 REMONUMENTATION  
19 JUL 95 2:03 P.M. RECEIPT# 71A  
PAID RECORDED - OAKLAND COUNTY  
LYNN D. ALLEN, CLERK/REGISTER OF DEEDS

For corners in

Oakland (county)	Located In:	Corner Code #
1. Public Land Survey	T1N R8E H-7	
	T R	
	T R	
	T R	
2. Property Controlling in Section	S T R	
	S T R	
3. Miscellaneous Property in Sec.	S T R	
	S T R	

Compliance with  
ACT 345, P.A. 1990  
APPROVED ON: 7-12-95 Toms  
OAKLAND COUNTY REMONUMENTATION  
PEER GROUP COMMITTEE

Register of Deeds Stamp & File Number

4. Lot No. \_\_\_\_\_, Recorded Plat

5. Private Claims

I, Joseph C. Kapelczak, in a field survey on March 2, 1995, do hereby certify that under requirements of P.A. 74, Michigan P.A. of 1970, the corner points mentioned in lines 1 and 2 above were in conformance with regulations and rules therefore as required in the current manual of survey instructions of the United States Department of the Interior, Bureau of Land Management or by a decree of a Court of Law and/or that the corner points mentioned in lines 3, 4 and 5 above were in conformance with the rules of the Michigan Board of Land Surveyors or by a Decree of a Court of Law; established, re-established, monumented, re-monumented, recovered, found as expressed below:

NOTE: Not more than 4 corners, all in the same town and range, may be recorded on this certificate.

A. Description of original monument and accessories and/or subsequent restoration:

Post set 1816 G.O.L. survey; N 3 E 18lks, 6"Elm; S 6 W 11lks, 12" Liden.  
LCRC L 8335 P 570  
Kapelczak 1982  
Fd 1/2" rerod  
N 24 E 52.06' Nail with capsoutheast side 8" sumac  
N 69 E 104.69' Nail with J&A cap south side power pole  
S 50 E 105.15' Nail with cap west side 6"Elm  
South 52.22' Nail with cap east side power pole  
N 72 W 53.58' Nail with cap southwest side 26" Elder



B. Description of corner evidence found and/or method applied in restoring or reestablishing corner:  
Recovered 1/2"rerod cap #24598 in mon. box, 4.70 north of centerline 11 Mile Rd.

Recovered witnesses:

N 52 W 58.61' Nail tag #17623 s.west side power pole	N 72 E 104.36' Nail tag #17623 s.east side power pole
N 52 W 58.68' Nail tag #17623 s.west side power pole	S 08 W 52.42' PK west side power pole
N 52 W 58.69' Nail M.D.S.H. washer s.west side power pole	S 07 W 52.51' nail&washer east power pole
N 52 W 58.70' Nail southwest side power pole	S 07 W 52.61' nail tag #12584 east side power pole
N 35 W 41.33' 1/2" rerod s.west corner pancel #22-15-378-007	
N 09 W 19.65' Nail tag #21297 west side 8" Cedar	
N 27 E 21.18' PK tag #12584 s.east side 10" Cherry	
S 55 E 68.20' PK w/shinner n.east side 12" Mulberry	

C. Description of monument for corner and accessories established to perpetuate locating the position of the corner:

Set 5/8" rerod with O.C. remonumentation brass cap replacing 1/2" rerod  
N 52 W 58.68' PK/remon tag southwest side power pole  
N 72 E 104.32' PK/remon tag southeast side power pole  
S 08 W 52.54' PK/remon tag west side power pole  
S 54 E 68.02' PK/remon tag southwest 12" dia. Mulberry

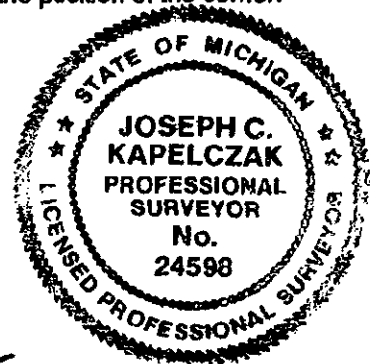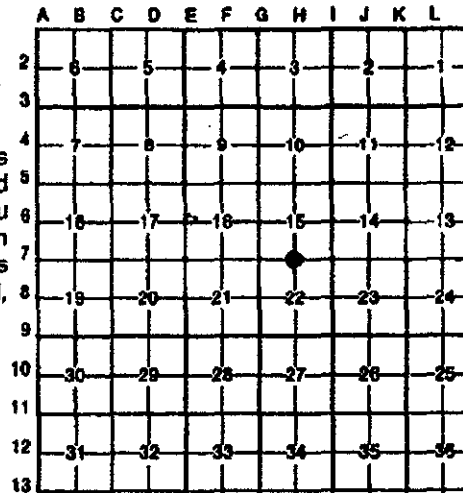

Signed by Joseph C. Kapelczak  
Surveyor's Michigan License No. 24598

Date 6/28/95