

LAND CORNER RECORDATION CERTIFICATE
Filing Requirement of Act 74, Mich. P.A. 1970

For corners in

Table with columns: Oakland (county), Located In: (T1N, R8E, H-9), Corner Code #. Rows include Public Land Survey, Property Controlling in Section, and Miscellaneous Property in Sec.

\$ 7.00 MISCELLANEOUS RECORDING
\$ 2.00 REMONUMENTATION
19 JUL 95 2:03 P.M. RECEIPT# 71A
PAID RECORDED - OAKLAND COUNTY
LYNN D. ALLEN, CLERK/REGISTER OF DEEDS


Compliance with ACT 345, P.A. 1990
APPROVED ON: 7-12-95 Tms
OAKLAND COUNTY REMONUMENTATION PEER GROUP COMMITTEE

Register of Deeds Stamp & File Number

4. Lot No. _____, Recorded Plat _____

5. Private Claims _____

I, Joseph C. Kapelczak, in a field survey on May 2, 1995, do hereby certify that under requirements of P.A. 74, Michigan P.A. of 1970, the corner points mentioned in lines 1 and 2 above were in conformance with regulations and rules therefore as required in the current manual of survey instructions of the United States Department of the Interior, Bureau of Land Management or by a decree of a Court of Law and/or that the corner points mentioned in lines 3, 4 and 5 above were in conformance with the rules of the Michigan Board of Land Surveyors or by a Decree of a Court of Law, established, re-established, monumented, re-monumented, recovered, found as expressed below:

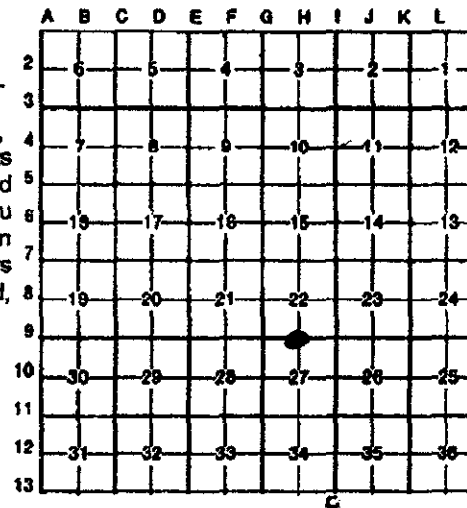

NOTE: Not more than 4 corners, all in the same town and range, may be recorded on this certificate.

A. Description of original monument and accessories and/or subsequent restoration:

- Post set in 1816 G.O.L. survey; N 7 W 7lks, 4" ash; S 27 W 17lks, 18" ash.
LCRC L 6312 P 57
Titworth 1974
Fd 5/8" rerod
N 05 W 34.22' PK nail east side corner fence post
S 45 W 30.42' PK nail n.west side 20" Ash
S 50 E 33.91' PK nail n.east side 24" Ash
LCRC L7743 P34
Lippincott 1980
Fd 1/2" rerod
*N 10 E 33.21' Nail O.C.R.C. washer in power pole
*N 65 E 85.42' Nail O.C.R.C. washer in power pole
South 33.00' Property pin
* South 60.00' Property pin
S 07 E 72.11' 7" Elm


B. Description of corner evidence found and/or method applied in restoring or reestablishing corner:

- Two PK nails found, location not confirmed with recovered witnesses.
Recovered witnesses are from reset 1/4 corner location;
*N 15 E 33.29' PK west side power pole
N 72 E 85.02' PK north side power pole
N 73 E 84.88' PK south side power pole
*N 73 E 85.24' Nail&washer southeast side power pole
N 65 W 103.50' PK southwest side power pole
*S 07 W 60.00' 1/2"rerod in monument (bent) northwest corner parcel #22-27-201-006

* confirms LCRC witnesses

C. Description of monument for corner and accessories established to perpetuate locating the position of the corner:

- Set 5/8" rerod with O.C. remonumentation brass cap in new monument box
N 15 E 33.33' PK/remon tag west side power pole
S 22 W 71.84' Chiseled cross northwest bolt on light pole base
N 04 E 121.52' PK/remon tag west side power pole
S 40 E 83.74' PK/remon tag northeast side 8" dia. elm

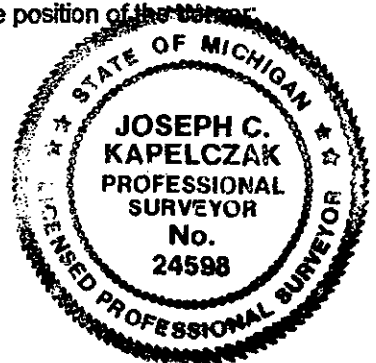

Signed by Joseph C. Kapelczak
Surveyor's Michigan License No. 24598

Date 6/28/95

Handwritten note: 7.00 2.00