

COPY

JUL 1995 129151

15528-771

LAND CORNER RECORDATION CERTIFICATE
Filing Requirement of Act 74, Mich. P.A. 1970

For corners in

Table with columns: Oakland (county), Located In: (T1N, R8E, I-9), Corner Code #. Rows include Public Land Survey, Property Controlling in Section, and Miscellaneous Property in Sec.

\$ 7.00 MISCELLANEOUS RECORDING
\$ 2.00 REMONUMENTATION
19 JUL 95 2:03 P.M. RECEIPT# 71A
PAID RECORDED - OAKLAND COUNTY
LYNN D. ALLEN, CLERK/REGISTER OF DEEDS

Compliance with ACT 345, P.A. 1990
APPROVED ON: 7-12-95 TMB
OAKLAND COUNTY REMONUMENTATION PEER GROUP COMMITTEE

Register of Deeds Stamp & File Number

4. Lot No. Recorded Plat


5. Private Claims

I, Joseph C. Kapelczak, in a field survey on February 10, 1995, do hereby certify that under requirements of P.A. 74, Michigan P.A. of 1970, the corner points mentioned in lines 1 and 2 above were in conformance with regulations and rules therefore as required in the current manual of survey instructions of the United States Department of the Interior, Bureau of Land Management or by a decree of a Court of Law and/or that the corner points mentioned in lines 3, 4 and 5 above were in conformance with the rules of the Michigan Board of Land Surveyors or by a Decree of a Court of Law; established, re-established, monumented, re-monumented, recovered, found as expressed below.

NOTE: Not more than 4 corners, all in the same town and range, may be recorded on this certificate.

A. Description of original monument and accessories and/or subsequent restoration:

Post set in 1816 G.O.L. survey: N 75 W 20lks, 10" Ash; S 75 E 27lks, 13" Beech.
LCRC L 7743 P 34 Lippincott 1980 FD. 1" iron in mon. box
N 45 E 51.53' nail w/washer in p.p.
S 40 E 56.66' nail w/washer in p.p.
S 40 W 63.00' nail w/washer in p.p.
N 45 W 51.14' nail w/washer in p.p.
LCRC L 8178 P 526 Graham 1982 FD. 1" iron pipe
N 45 W 51.14' nail w/washer south side p.p.
N 45 E 51.53' nail w/washer west side p.p.
S 40 W 63.00' nail w/washer east side p.p.
LCRC L 11062 P 233 Donnelly 1989 FD. 1" iron rod in mon. box
N 45 E 51.53' nail w/washer in p.p.
S 40 E 56.66' nail w/washer in p.p.
S 40 W 63.00' nail w/washer in p.p.
N 45 W 51.14' nail w/washer in p.p.

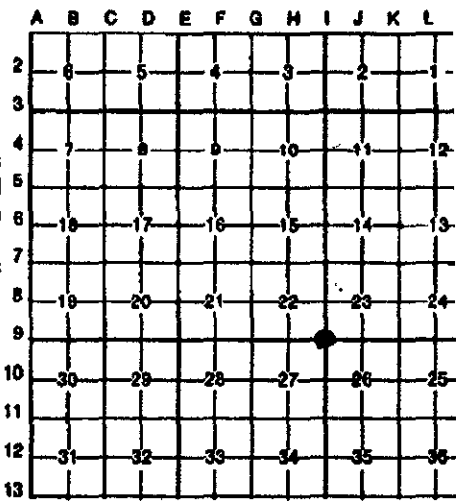


B. Description of corner evidence found and/or method applied in restoring or reestablishing corner:

Recovered 1/2" rerod in monument box at centerline of Novi Rd. & 10 Mile Rds.
Recovered witnesses:
N 41 W 77.03' PK nail northeast side power pole
N 31 E 71.79' PK nail northwest side telephone pole
S 31 E 56.99' PK nail northeast side power pole
N 44 E 72.42' PK nail west side power pole
S 45 W 75.60' PK nail northwest side power pole

C. Description of monument for corner and accessories established to perpetuate locating the position of the corner:

Set 5/8" rerod with O.C. Remonumentation brass cap replacing 1/2" rerod.
N 41 W 77.98' PK/remon tag northeast side power pole
N 45 E 72.53' PK/remon tag southeast side power pole
S 41 E 57.06' PK/remon tag northeast side power pole
S 45 W 75.45' PK/remon tag northwest side power pole

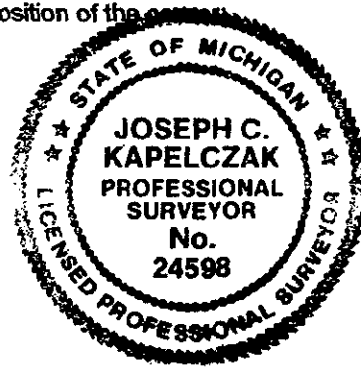

Signed by Joseph C. Kapelczak
Surveyor's Michigan License No. 24598

Date 6/28/95