

COPY

LIBER 168500429

DEC 19 96 3063

LAND CORNER RECORDATION CERTIFICATE
Filing Requirement of Act 74, Mich. P.A. 1970

For corners in

Table with columns: Oakland (county), Located in:, Corner Code #. Rows include Public Land Survey, Property Controlling in Section, and Miscellaneous Property in Sec.

\$ 7.00 MISCELLANEOUS RECORDING
\$ 2.00 REMONUMENTATION
19 DEC 96 11:03 A.M. RECEIPT# 178
PAID RECORDED - OAKLAND COUNTY
LYNN D. ALLEN, CLERK/REGISTER OF DEEDS

APPROVED BY: 10-2-96
Register of Deeds Stamp & File Number

4. Lot No. Recorded Plat

5. Private Claims

I, Joseph C. Kapelczak, in a field survey on 29 January, 1996, do hereby certify that under requirements of P.A. 74, Michigan P.A. of 1970, the corner points mentioned in lines 1 and 2 above were in conformance with regulations and rules therefore as required in the current manual of survey instructions of the United States Department of the Interior, Bureau of Land Management or by a decree of a Court of Law and/or that the corner points mentioned in lines 3, 4 and 5 above were in conformance with the rules of the Michigan Board of Land Surveyors or by a Decree of a Court of Law; established, re-established, monumented, re-monumented, recovered, found as expressed below:

NOTE: Not more than 4 corners, all in the same town and range, may be recorded on this certificate.

A. Description of original monument and accessories and/or subsequent restoration:


- List of monuments and accessories including descriptions like 'Post set in 1816 G.L.O. survey', 'LCRC L.8335, P.572, Kapelczak 1982', 'LCRC L.10017, P.819, Ward 1987', etc.

B. Description of corner evidence found and/or method applied in restoring or reestablishing corner:

Recovered 1/2" Iron in Monument Box centerline 42' wide Bit. Rd. and 56' west centerline Decker Road & Recovered witnesses: S 14 W 40.16' PK nail east side power pole, S 15 W 40.28' PK nail w/shiner west side power pole, N 36.53' nail w/tag #17552 west side M.B.T. pole, N 04 W 69.27' PK nail w/shiner west side power pole, N 76 W 326.56 1" pipe southwest corner parcel #22-02-382-004

C. Description of monument for corner and accessories established to perpetuate locating the position of the corner:

Set Remonumentation brass cap. S 15 W 40.35' nail w/remon tag west side power pole, N 04 W 69.22' nail w/remon tag west side power pole, N 80 E 163.74' nail w/remon tag south side M.B.T. pole, S 29 W 151.95' nail w/remon tag north side power pole

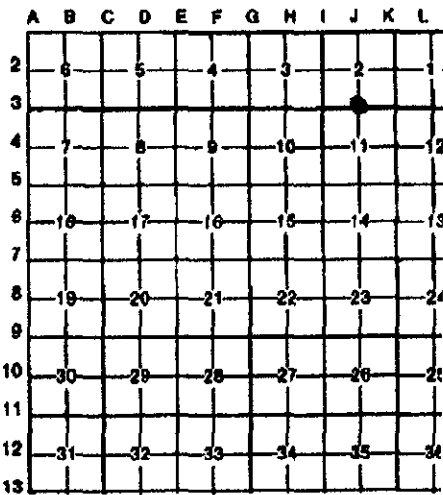

SURVEY & REMONUMENTATION

MAY 22 1997

COMMISSION



Signed by Joseph C. Kapelczak
Surveyor's Michigan License No. 24598

Date 10/1/96