

LAND CORNER RECORDATION CERTIFICATE
Filing Requirement of Act 74, Mich. P.A. 1970

\$ 7.00 MISCELLANEOUS RECORDING
\$ 2.00 REMONUMENTATION
19 JUL 95 2:05 P.M. RECEIPT# 71A
PAID RECORDED - OAKLAND COUNTY
LYNN D. ALLEN, CLERK/REGISTER OF DEEDS

For corners in

Oakland (county) Located In: Corner Code #
1. Public Land Survey T1N R8E K-10
2. Property Controlling in Section S T R
3. Miscellaneous Property in Sec. S T R

Compliance with ACT 345, P.A. 1990
APPROVED ON: 7-12-95 Tom S.
OAKLAND COUNTY REMONUMENTATION PEER GROUP COMMITTEE

Register of Deeds Stamp & File Number

4. Lot No. , Recorded Plat

5. Private Claims

I, Joseph C. Kapelczak, in a field survey on February 1, 1995, do hereby certify that under requirements of P.A. 74, Michigan P.A. of 1970, the corner points mentioned in lines 1 and 2 above were in conformance with regulations and rules therefore as required in the current manual of survey instructions of the United States Department of the Interior, Bureau of Land Management or by a decree of a Court of Law and/or that the corner points mentioned in lines 3, 4 and 5 above were in conformance with the rules of the Michigan Board of Land Surveyors or by a Decree of a Court of Law; established, re-established, monumented, re-monumented, recovered, found as expressed below:

NOTE: Not more than 4 corners, all in the same town and range, may be recorded on this certificate.

A. Description of original monument and accessories and/or subsequent restoration:

Post set in 1816 G.O.L. survey: N 55 E 2 1/2lks, 7" Elm; S 24 W 17lks, 8" Elm.
No Land Corner Recordation Certificates recorded

B. Description of corner evidence found and/or method applied in restoring or reestablishing corner:

Recovered 1/2" rered in monument box on centerline Meadowbrook Rd.

Recovered witnesses:

- East 61.30' Nail tag #28400(GLA) south side power pole
N 89 E 61.25' Nail w/OCRC tag north side power pole
West 58.07' Nail tag #28400 north side power pole
N 89-36 E 59.89' 1" pipe southwest corner lot


C. Description of monument for corner and accessories established to perpetuate locating the position of the corner:

Set 5/8" rered with O.C. remonumentation brass cap replcing 1/2" rered

- N 88-30 E 61.20' PK/remon tag north side power pole
S 60 E 60.35' PK/remon tag southwest side twin 12" dia. Poplar
S 24 W 146.51' PK/remon tag east side power pole with transformer
West 58.07' PK/remon tag north side power pole

Signed by Joseph C. Kapelczak
Surveyor's Michigan License No. 24598

Date 6/28/95

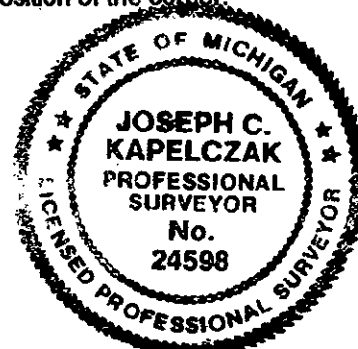

7.00
2.00
RW

Grid table with columns A-L and rows 1-13. Cell (10, 25) contains a dot.