

LAND CORNER RECORDATION CERTIFICATE
Filing Requirement of Act 74, Mich. P.A. 1970

For corners in

\$ 7.00 MISCELLANEOUS RECORDING
\$ 2.00 REMONUMENTATION
19 JUL 95 2:05 P.M. RECEIPT# 71A
PAID RECORDED - OAKLAND COUNTY
LYNN D. ALLEN, CLERK/REGISTER OF DEEDS

Table with columns: Oakland (county), Located In:, Corner Code #. Rows include Public Land Survey, Property Controlling in Section, and Miscellaneous Property in Sec.

Compliance with ACT 345, P.A. 1990
APPROVED ON: 7-12-95 JMS
OAKLAND COUNTY REMONUMENTATION PEER GROUP COMMITTEE

Register of Deeds Stamp & File Number

4. Lot No. , Recorded Plat

5. Private Claims

I, Joseph C. Kapelczak, in a field survey on February 8, 1995, do hereby certify that under requirements of P.A. 74, Michigan P.A. of 1970, the corner points mentioned in lines 1 and 2 above were in conformance with regulations and rules therefore as required in the current manual of survey instructions of the United States Department of the Interior, Bureau of Land Management or by a decree of a Court of Law and/or that the corner points mentioned in lines 3, 4 and 5 above were in conformance with the rules of the Michigan Board of Land Surveyors or by a Decree of a Court of Law, established, re-established, monumented, re-monumented, recovered, found as expressed below.

NOTE: Not more than 4 corners, all in the same town and range, may be recorded on this certificate.

A. Description of original monument and accessories and/or subsequent restoration:

Post set in 1816 G.O.L. survey: N 59 1/2 E 5lks, 7" Ironwood; S 67 W 20lks, 24" Oak. LCRC L 7716 P213 Anderson 1980 Fd. iron in mon. box S 45 W 84.43' Nail n.west side 24" Maple S 45 E 36.98' Nail n.east side 24" Maple East 58.52' Nail north side power pole West 60.67' Nail south side 20" Hickory S 36 W 83.65' Set 60d nail & disc north face 24" Elm \*S 51 W 45.52' Set 60d nail & disc southeast face utility pole N 89 W 60.73' Fd. PK nail south face 14" Elm \*S 88 E 58.61' Set 60d nail & disc north face utility pole

Grid table with columns A-L and rows 2-13. Contains numerical values for each cell.

B. Description of corner evidence found and/or method applied in restoring or reestablishing corner:

Recovered 1/2" rerod cap # 24598 in monument box on centerline Meadowbrook Rd.

Recovered witnesses:

S 87 W 60.67' PK washer #24598(JCK) south side 12" Hickory
\*S 49 W 45.53' Nail washer # 80777(GW) northeast side power pole w/civil defense siren
\*N 89 E 58.62' Nail washer #80780 north side power pole
S 89 E 59.98' 1/2" rerod in concrete monument Subdivision corner
N 89 W 1/2" rerod in concrete monument Subdivision corner


Handwritten: ^ 59.9 JCK

\* confirms LCRC witness

C. Description of monument for corner and accessories established to perpetuate locating the position of the corner:

Set 5/8" rerod with O.C. Remonumentation brass cap replacing 1/2" rerod

East 58.08' PK/remon tag west side power pole
S 40 W 152.95' Chiseled cross northeast bolt of light pole base
S 49 W 45.56' PK/remon tag northeast side power pole w/civil defence siren
S 87 W 60.70' PK/remon tag south side 12" dia. Hickory

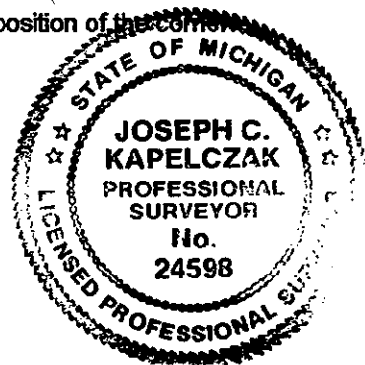

Signed by Joseph C. Kapelczak
Surveyor's Michigan License No. 24598

Date 6/28/95