

LAND CORNER RECORDATION CERTIFICATE
Filing Requirement of Act 74, Mich. P.A. 1970

For corners in

Table with columns: Oakland (county), Located In, Corner Code #. Rows include Public Land Survey, Property Controlling in Section, and Miscellaneous Property in Sec.

\$ 7.00 MISCELLANEOUS RECORDING
\$ 2.00 REMONUMENTATION
19 JUL 95 2:06 P.M. RECEIPT# 71A
PAID RECORDED - OAKLAND COUNTY
LYNN D. REGISTER OF DEEDS

APPROVED ON: 7-12-95
OAKLAND COUNTY REMONUMENTATION
PEER GROUP COMMITTEE

Register of Deeds Stamp & File Number

4. Lot No. Recorded Plat
5. Private Claims

I, Joseph C. Kapelczak, in a field survey on February 7, 1995, do hereby certify that under requirements of P.A. 74, Michigan P.A. of 1970, the corner points mentioned in lines 1 and 2 above were in conformance with regulations and rules therefore as required in the current manual of survey instructions of the United States Department of the Interior, Bureau of Land Management or by a decree of a Court of Law and/or that the corner points mentioned in lines 3, 4 and 5 above were in conformance with the rules of the Michigan Board of Land Surveyors or by a Decree of a Court of Law, established, re-established, monumented, re-monumented, recovered, found as expressed below.

Grid table with columns A-L and rows 2-13. Contains numerical data points for survey locations.

NOTE: Not more than 4 corners, all in the same town and range, may be recorded on this certificate.

A. Description of original monument and accessories and/or subsequent restoration:
Post set in 1816 G.O.L. survey: N 29 W 4lks, 24" White oak; S 16 W 20lks, 11" Elm.

No LCRCs recorded.

B. Description of corner evidence found and/or method applied in restoring or reestablishing corner:

Recovered 1/2" rerod cap #24598 in monument box on centerline 9 Mile Rd.


Recovered witnesses:

- N 39 E 74.31' Found 1/2" rerod southeast corner lot 120 Heatherwyke Subdivision
N 68 E 138.51' Nail w/CPCO shinner west side power pole
N 62 W 138.78' Nail w/CPCO shinner east side power pole

C. Description of monument for corner and accessories established to perpetuate locating the position of the corner:

Set 5/8" rerod with O.C. Remonumentation brass cap replacing 1/2" rerod.

- N 35 W 41.54' PK/remon tag northeast side 36" dia. Oak
S 71 W 56.81' PK/remon tag north side 16" dia. Oak
S 74 W 73.37' PK/remon tag north side 16" Cherry
N 67 W 63.01' PK/remon tag south side 14" dia. Walnut

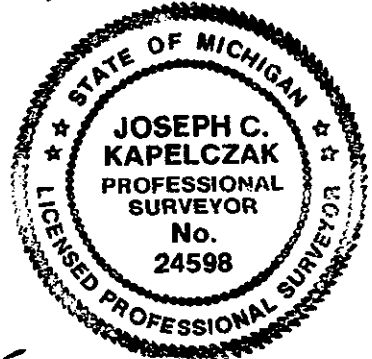

Signed by Joseph C. Kapelczak
Surveyor's Michigan License No. 24598

Date 6/28/95