

COPY

LAND CORNER RECORDATION CERTIFICATE
Filing Requirement of Act 74, Mich. P.A. 1970

For corners in

Table with columns: Oakland (county), Located In: (T1N, R8E, M-4), Corner Code #. Rows include Public Land Survey, Property Controlling in Section, and Miscellaneous Property in Sec.

\$ 7.00 MISCELLANEOUS RECORDING
\$ 2.00 REMONUMENTATION
19 DEC 96 11:05 A.M. RECEIPT# 178
PAID RECORDED - OAKLAND COUNTY
LYNN D. ALLEN, CLERK/REGISTER OF DEEDS

APPROVED BY: 11-6-96
Register of Deeds Stamp & File Number

4. Lot No. , Recorded Plat

5. Private Claims

I, Joseph C. Kapelczak, in a field survey on September 7, 1995, do hereby certify that under requirements of P.A. 74, Michigan P.A. of 1970, the corner points mentioned in lines 1 and 2 above were in conformance with regulations and rules therefore as required in the current manual of survey instructions of the United States Department of the Interior, Bureau of Land Management or by a decree of a Court of Law and/or that the corner points mentioned in lines 3, 4 and 5 above were in conformance with the rules of the Michigan Board of Land Surveyors or by a Decree of a Court of Law; established, re-established, monumented, re-monumented, recovered, found as expressed below:

NOTE: Not more than 4 corners, all in the same town and range, may be recorded on this certificate.

A. Description of original monument and accessories and/or subsequent restoration:

- Post set in 1816 G.L.O. Survey. N 48-1/2 W 24 lks, 18" Beech. N 32 W 55 lks 18" Beech
L.C.R.C. Schultz 1989 L.10966 P.429
Re-set 1/2" copper clad rod in new monument box w/cap #31610 in same location
N 55 E 78.72' nail w/MDOT tag in power pole
E 56.60' PK nail w/MDOT tag in sidewalk
N 05 W 58.48' nail w/MDOT tag in power pole
S 55 E 65.92' PK nail w/MDOT tag in sidewalk
N 2637.12' 3/4" iron in monument box
S 2762.51' 3/8" rod in concrete monument

B. Description of corner evidence found and/or method applied in restoring or reestablishing corner:


- Recovered 1/2" rerod w/cap #31610 in monument box centerline Bit. Road.
Recovered witnesses.
N 53 E 78.66' nail w/MDOT tag north side power pole
N 53 E 78.95' nail w/G.W. tag #31606 north side power pole
W 58.40' nail w/MSHD tag south side power pole
N 02 E 70.00' Farmington Twp. A-4

C. Description of monument for corner and accessories established to perpetuate locating the position of the corner:

- Set remonumentation brass cap.
W 58.34' set nail w/remon tag south side power pole
N 51 E 78.77' chisled "+" southwest corner MBT pad
S 18 W 167.16' set nail w/remon tag west side 16" Pine
S 22 W 185.79' set nail w/remon tag west side 14" Pine

Grid table with columns A-L and rows 2-13. Contains numbers 1-35 in a grid pattern.

SURVEY & REMONUMENTATION
MAY 22 1997
COMMISSION

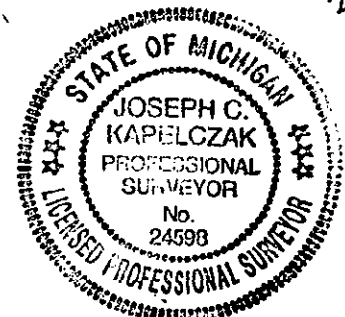

Signed by Joseph C. Kapelczak
Surveyor's Michigan License No. 24598

Date 11/6/96