

COPY

LIBER 16874 PG 149

JAN 397001295

LAND CORNER RECORDATION CERTIFICATE
Filing Requirement of Act 74, Mich. P.A. 1970

For corners in

Table with columns: Oakland (county), Located In:, Corner Code #. Rows include Public Land Survey, Property Controlling in Section, and Miscellaneous Property in Sec.

\$ 7.00 MISCELLANEOUS RECORDING
\$ 2.00 REMONUMENTATION
3 JAN 97 7:50 A.M. RECEIPT# 88
PAID RECORDED - OAKLAND COUNTY
LYNN D. ALLEN, CLERK/REGISTER OF DEEDS

Compliance with
ACT 345, P.A. 1990

APPROVED ON: 12-9-96 TS
OAKLAND COUNTY REMONUMENTATION
PEER GROUP COMMITTEE

Register of Deeds Stamp & File Number

4. Lot No. , Recorded Plat

5. Private Claims

I, Joseph C. Kapelczak, in a field survey on January 29, 1996, do hereby certify that under requirements of P.A. 74, Michigan P.A. of 1970, the corner points mentioned in lines 1 and 2 above were in conformance with regulations and rules therefore as required in the current manual of survey instructions of the United States Department of the Interior, Bureau of Land Management or by a decree of a Court of Law and/or that the corner points mentioned in lines 3, 4 and 5 above were in conformance with the rules of the Michigan Board of Land Surveyors or by a Decree of a Court of Law; established, re-established, monumented, re-monumented, recovered, found as expressed below:

NOTE: Not more than 4 corners, all in the same town and range, may be recorded on this certificate.

A. Description of original monument and accessories and/or subsequent restoration:

Post set 1815 G.L.O. survey: N 80°W 4lks, 6" Ash; S 74°W 29lks, 11" Ash.

- LCRC L11057 P819
Roon 1989 1/2" iron in monument box.
N 56°W 57.72' Spike in PP & TP
N 35°E 94.91' Face street sign
N 76°E 75.23' Fire Hydrant top centerline
S 75°W 58.59' Nail 22" Maple

SURVEY &
REMONUMENTATION

MAY 22 1997

COMMISSION

B. Description of corner evidence found and/or method applied in restoring or reestablishing corner:

Recovered 1/2" rerod in monument box on centerline Haggerty Road.

Recovered Witnesses:

- N 61°W 58.02' Nail/tag #B.M. southwest side power pole
N 61°W 58.07' Nail/tag #O.C.R.C. southwest side power pole
S 71°W 58.23' PK/tag #8386 south side 3-10" Maples
N 81°E 39.96' PK/tag #8386 southeast side power pole
S 54°E 90.40' PK/tag #8386 southwest side power pole
N 03°E 54.43' 1/2" rerod in monument box A-6 Farmington Hills T 1N,R9E.


700 FILE
200

C. Description of monument for corner and accessories established to perpetuate locating the position of the corner:

Set Oakland County remonumnetation brass cap on existing 1/2" rerod.

Witnesses Set:

- N 23°W 109.94' PK/remon tag southwest side power pole
N 61°W 58.06' PK/remon tag southwest side power pole
N 80°E 39.75' PK/remon tag north side power pole
S 54°E 90.50' PK/remon tag southwest side power pole

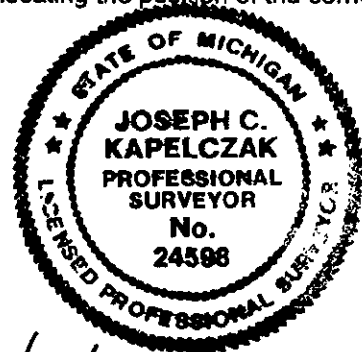

Signed by Joseph C. Kapelczak

Date 12/16/96

Surveyor's Michigan License No. 24598