

COPY

LIBER 16982 PG 809

FEB 12 97 03509

LAND CORNER RECORDATION CERTIFICATE
Filing Requirement of Act 74, Mich. P.A. 1970

For corners in

<u>Oakland</u> (county)	Located In:	Corner Code #
1. Public Land Survey	T1N R8E	M-7
	T R	
	T R	
	T R	
2. Property Controlling in Section	S T R	
	S T R	
3. Miscellaneous Property in Sec.	S T R	
	S T R	

\$ 7.00 MISCELLANEOUS RECORDING
 \$ 2.00 REMONUMENTATION
 12 FEB 97 9:14 A.M. RECEIPT# 59A
 PAID RECORDED - OAKLAND COUNTY
 LYNN D. ALLEN, CLERK/REGISTER OF DEEDS

Compliance with
 ACT 345, P.A. 1990
 12-9-96 TS
 COUNTY REMONUMENTATION
 COMMITTEE

Register of Deeds Stamp & File Number

4. Lot No. _____ Recorded Plat _____

5. Private Claims _____

I, Joseph C. Kapelczak, in a field survey on January 29 1996, do hereby certify that under requirements of P.A. 74, Michigan P.A. of 1970, the corner points mentioned in lines 1 and 2 above were in conformance with regulations and rules therefore as required in the current manual of survey instructions of the United States Department of the Interior, Bureau of Land Management or by a decree of a Court of Law and/or that the corner points mentioned in lines 3, 4 and 5 above were in conformance with the rules of the Michigan Board of Land Surveyors or by a Decree of a Court of Law, established, re-established, monumented, re-monumented, recovered, found as expressed below:

A	B	C	D	E	F	G	H	I	J	K	L	M
2	6	5	4	3	2	1						
3												
4	7	8	9	10	11	12						
5												
6	16	17	18	19	20	21	22	23	24			
7												
8	19	20	21	22	23	24						
9												
10	30	29	28	27	26	25						
11												
12	31	32	33	34	35	36						
13												

NOTE: Not more than 4 corners, all in the same town and range, may be recorded on this certificate.

A. Description of original monument and accessories and/or subsequent restoration:

Post set 1815 G.L.O. survey: S 85°W 37lks, 14" Sugar; N 40°W 30lks, 8" Beech.

LCRC L11057 P817
 Roon 1989 Fd. 1" bolt, 2' west of centerline Haggerty Rd.
 *S 35°W 34.51' Nail in top G.R. post
 *N 15°W 73.41' Nail in top G.R. post
 *N 28° E 71.27' Nail in top G.R. post
 *S 24° E 34.12' Nail in top G.R. post
 *North 44.25' Sec.Cor. common to 18 & 19

LCRC L11062 P213
 Donnelly 1989 Fd. 1" square iron
 North 44.22' 1" square bar in monument box
 *N 16°E 71.24' Doubleheaded nail w/MDOT tag in top G.R. post
 *S 42°E 34.14' Doubleheaded nail w/MDOT tag in top G.R. post
 *S 30°W 34.51' Doubleheaded nail w/MDOT tag in top G.R. post
 *N 17°W 73.37' Doubleheaded nail w/MDOT tag in top G.R. post

B. Description of corner evidence found and/or method applied in restoring or reestablishing corner:

Recovered 5/8" bolt 1.50' west of centerline Haggerty Road. (No monument box).

Recovered Witnesses:

*N 22°E 71.26' Nail/tag #MDOT in top of guard rail post
 *S 36°E 34.11' Nail/tag #MDOT in top of guard rail post
 *S 37°W 34.51' Nail/tag #MDOT in top of guard rail post
 *N 11°W 73.35' Nail/tag #MDOT in top of guard rail post
 N 09°E 20.34' Nail/tag #MDOT in centerline road
 *N 04°E 44.24' 5/8" bolt, A-7 Farmington Hills T1.N, R8.E (no monument box)

SURVEY & REMONUMENTATION

MAY 22 1997


COMMISSION

700 FILE
2W

C. Description of monument for corner and accessories established to perpetuate locating the position of the corner:

Set Oakland County remonumentation brass cap in bridge deck (no monument box).

N 23°E 67.89' Set 1/2" rerod
 S 39°E 31.54' Set 1/2" rerod
 S 39°W 31.41' Set 5/8" rerod
 N 16°W 52.03' Set 1/2" rerod

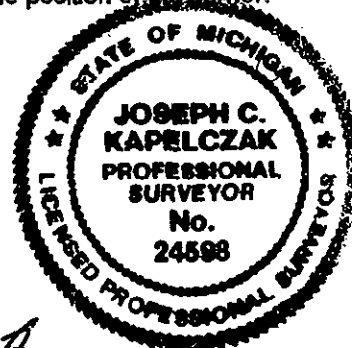

Signed by Joseph C. Kapelczak

Date 12/11/96

Surveyor's Michigan License No. 24598