

COPY

JAN 3 97 001283

LIBER 16874 PG 129

LAND CORNER RECORDATION CERTIFICATE
Filing Requirement of Act 74, Mich. P.A. 1970

\$ 9.00 MISCELLANEOUS RECORDING
\$ 2.00 REMONUMENTATION
3 JAN 97 7:48 A.M. RECEIPT# 88
PAID RECORDED - OAKLAND COUNTY
LYNN D. ALLEN, CLERK/REGISTER OF DEEDS

For corners in

Table with columns: Oakland (county), Located In:, Corner Code #. Rows include Public Land Survey, Property Controlling in Section, and Miscellaneous Property in Sec.

Compliance with ACT 345, P.A. 1990
APPROVED ON: 12-9-96 JS
OAKLAND COUNTY REMONUMENTATION PEER GROUP COMMITTEE

Register of Deeds Stamp & File Number

4. Lot No. Recorded Plat
5. Private Claims

1. Joseph C. Kapelczak in a field survey on January 29, 1996, do hereby certify that under requirements of P.A. 74, Michigan P.A. of 1970, the corner points mentioned in lines 1 and 2 above were in conformance with regulations and rules therefore as required in the current manual of survey instructions of the United States Department of the Interior, Bureau of Land Management or by a decree of a Court of Law and/or that the corner points mentioned in lines 3, 4 and 5 above were in conformance with the rules of the Michigan Board of Land Surveyors or by a Decree of a Court of Law; established, re-established, monumented, re-monumented, recovered, found as expressed below:

Grid table with columns A-M and rows 2-13, containing numbers 1-36.

NOTE: Not more than 4 corners, all in the same town and range, may be recorded on this certificate.

A. Description of original monument and accessories and/or subsequent restoration:

- List of monuments: Post set in 1815 G.L.O. survey; LCRC L5871 P893; Jones 1972 Fd. 3/8" rerod; N 35 E 46.06' Corner fence post; S 55 E 30.24' Power pole; West 49.50' Power pole; \*North 38.40' West 1/4 corner Sec. 19 Farmington Hills; LCRC L7300 P648; Stonerock Fd. 3/8" iron; N 35 E 46.06' Corner fence post; S 55 E 30.24' Power pole; West 49.50' Power pole; LCRC L7433 P409; Landini 1978 Fd. iron in road box; N 40 E 46.27' Fence corner; S 85 E Nail north face power pole; S 85 W Nail in s.east face power pole; \*North 38.39' Fd. iron in road box west 1/4 corner Sec. 19 Farmington Hills

B. Description of corner evidence found and/or method applied in restoring or reestablishing corner:

Recovered 5/8" rerod in monument box 1.50' east of centerline Haggerty Road.

Recovered witnesses:

- S 77 E 31.77' Nail north side power pole.
N 87 W 49.33' Nail/tag south side power pole
N 88 W 151.82' Fence corner
\*N 05 E 38.34' 5/8" rerod in monument box, A-8 of Farmington Hills T1.N, R8.E

\*confirms LCRC witness

SURVEY & REMONUMENTATION

MAY 22 1997


COMMISSION FILE

C. Description of monument for corner and accessories established to perpetuate locating the position of the corner:

Set Oakland County remonumentation brass cap on existing 5/8" rerod.

Witnesses Set:

- S 77 E 31.88' PK/remon tag north side power pole
N 65 E 59.60' Chiseled cross north rim sanitary manhole
N 87 W 49.46' PK/remon tag south side power pole
S 74 W 44.10' Chiseled cross north rim storm manhole
S 65 W 75.01' Tip of arrow on fire hydrant

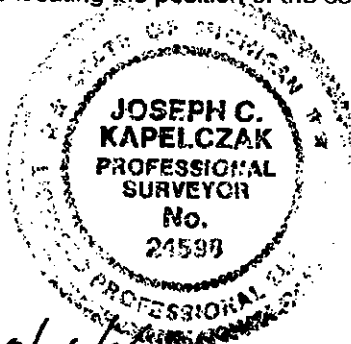

Signed by Joseph C. Kapelczak
Surveyor's Michigan License No. 24598

Date 12/14/96

**COPY**

LIBER **16874PG147**

JAN 397001290

**LAND CORNER RECORDATION CERTIFICATE**  
Filing Requirement of Act 74, Mich. P.A. 1970

\$ 7.00 MISCELLANEOUS RECORDING  
\$ 2.00 REMONUMENTATION  
3 JAN 97 7:50 A.M. RECEIPT# 88  
PAID RECORDED - OAKLAND COUNTY  
LYNN D. ALLEN, CLERK/REGISTER OF DEEDS

For corners in

<u>Oakland</u> (county)	Located In:	Corner Code #
1. Public Land Survey	T1N R8E	M-8 (page 2)
	T R	
	T R	
	T R	
2. Property Controlling in Section	S T R	
	S T R	
3. Miscellaneous Property in Sec.	S T R	
	S T R	

Compliance with  
ACT 345, P.A. 1990

APPROVED ON: 12-9-96 RS  
OAKLAND COUNTY REMONUMENTATION  
PEER GROUP COMMITTEE

Register of Deeds Stamp & File Number

4. Lot No. \_\_\_\_\_, Recorded Plat \_\_\_\_\_

5. Private Claims \_\_\_\_\_

I, Joseph C. Kapelczak, in a field survey on January 29, 1996, do hereby certify that under requirements of P.A. 74, Michigan P.A. of 1970, the corner points mentioned in lines 1 and 2 above were in conformance with regulations and rules therefore as required in the current manual of survey instructions of the United States Department of the Interior, Bureau of Land Management or by a decree of a Court of Law and/or that the corner points mentioned in lines 3, 4 and 5 above were in conformance with the rules of the Michigan Board of Land Surveyors or by a Decree of a Court of Law; established, re-established, monumented, re-monumented, recovered, found as expressed below:

A	B	C	D	E	F	G	H	I	J	K	L	M
2	6	5	4	3	2	1						
3												
4	7	8	9	10	11	12						
5												
6	16	17	18	15	14	13						
7												
8	19	20	21	22	23	24						
9												
10	30	29	28	27	26	25						
11												
12	31	32	33	34	35	36						
13												


**NOTE: Not more than 4 corners, all in the same town and range, may be recorded on this certificate.**

A. Description of original monument and accessories and/or subsequent restoration:  
(page 2)

LCRC L11057 P817  
Roon 1989 Fd. 5/8" rod in mon. box  
\*N 85 W 49.39' Fd. nail in power pole  
N 64 E 70.68' Face of corner fence post  
\*S 73 E 31.83' Fd. nail in power pole  
S 31 E 77.04' Nail in 6" Ash

B. Description of corner evidence found and/or method applied in restoring or reestablishing corner:

C. Description of monument for corner and accessories established to perpetuate locating the position of the corner:

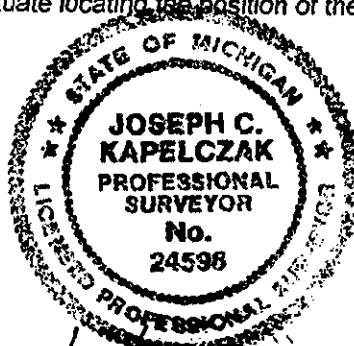

1.00  
2.00  
file

Signed by Joseph C. Kapelczak

Date 12/16/96

Surveyor's Michigan License No. 24598

FORM APPROVED BY MICHIGAN STATE BOARD OF LAND SURVEYORS, JAN. 28, 1971  
REVISED MAY 14, 1975  
REVISED JAN., 1983

**SURVEY &  
REMONUMENTATION**

MAY 22 1997

COMMISSION