

MAY 16 1996

COMMISSION

LAND CORNER RECORDATION CERTIFICATE
Filing Requirement of Act 74, Mich. P.A. 1970

15528 PC 757

COPY

For corners in

Oakland (county)	Located In:	Corner Code #
1. Public Land Survey	T1N R8E	M-9 (page 1)
	T R	
	T R	
	T R	
2. Property Controlling in Section	S T R	
	S T R	
3. Miscellaneous Property in Sec.	S T R	
	S T R	

\$ 9.00 MISCELLANEOUS RECORDING
 \$ 2.00 REMONUMENTATION
 19 JUL 95 2:01 P.M. RECEIPT# 71A
 PAID RECORDED - OAKLAND COUNTY
 LYNN D. ALLEN, CLERK/REGISTER OF DEEDS

Compliance with
 ACT 345, P.A. 1990

APPROVED ON: 7-12-95 JAWO
 OAKLAND COUNTY REMONUMENTATION
 PEER GROUP COMMITTEE

Register of Deeds Stamp & File Number

4. Lot No. _____, Recorded Plat

5. Private Claims

I, Joseph C. Kapelczak, in a field survey on April 11, 1995, do hereby certify that under requirements of P.A. 74, Michigan P.A. of 1970, the corner points mentioned in lines 1 and 2 above were in conformance with regulations and rules therefore as required in the current manual of survey instructions of the United States Department of the Interior, Bureau of Land Management or by a decree of a Court of Law and/or that the corner points mentioned in lines 3, 4 and 5 above were in conformance with the rules of the Michigan Board of Land Surveyors or by a Decree of a Court of Law; established, re-established, monumented, re-monumented, recovered, found as expressed below.

NOTE: Not more than 4 corners, all in the same town and range, may be recorded on this certificate.

A. Description of original monument and accessories and/or subsequent restoration:

Post set in 1816 G.O.L. survey: N 54 W 22lks, 16" Ash; S 36 W 32lks, 10" Beech.
 LCRC L 5871 P 895 LCRC L 6079 P 608
 Jones 1972 Fd. 1/2" pipe off of road Carlson 1973 Fd. 3/4" bar in road
 S 33 E 54.65' center top nut hydrant N 43 W 65.75' PK in Edison pole
 S 65 E 53.13' Telephone pole N 36 E 97.15' PK in Edison pole
 N 51 E 69.83' Power pole S 55-30 E 58.80' PK in Edison pole
 N 45 W 62.94' Power pole

LCRC L 7433 P 409
 Landini 1978 Fd. iron in road box
 Due south 12.03' of iron in road box
 S 45 W 71.09' Nail s.east face Edison pole
 N 40 W 66.69' Nail n. east face power pole
 S 42 E 69.45' N.west corner conc. pad for control box

Continued next page

B. Description of corner evidence found and/or method applied in restoring or reestablishing corner:

Recovered 5/8" pipe in monument box 12.10' south of centerline 10 Mile Rd. on centerline Haggerty Rd.

Recovered witnesses:


S 48 W 61.74' PK southeast side power pole
 *S 48 W 61.73' Nail tag #17623 south side power pole
 S 62 E 81.57' Nail tag #17623 soutehest side power pole
 *N 36 E 107.51' Nail tag #17623 southeast side power pole
 N 36 E 107.64' PK southeast side power pole
 *N 36 W 77.21' PK southwest side power pole
 S 16 W 263.89' Southeast fence corner parcel #22-25-226-011

* Confirms LCRC witness

C. Description of monument for corner and accessories established to perpetuate locating the position of the corner:

Set 5/8" rerod with O.C. Remonumentation brass cap replaing 5/8" pipe.

S 48 W 61.69' PK/remon tag southeast side power pole
 S 62 E 81.56' PK/remon tag northeast side power pole
 N 36 E 107.64' PK/remon tag southeast side power pole
 N 36 W 77.23' PK/remon tag southwest side power pole

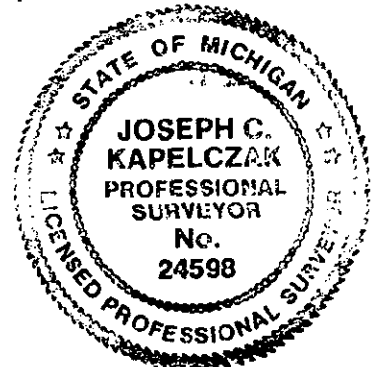

Signed by Joseph C. Kapelczak
 Surveyor's Michigan License No. 24598

Date 6/28/95

8/2/95

LAND CORNER RECORDATION CERTIFICATE
Filing Requirement of Act 74, Mich. P.A. 1970

For corners in

Oakland (county)	Located In:	Corner Code #
1. Public Land Survey	T1N R8E	M-9 (page 2)
	T R	
	T R	
	T R	
2. Property Controlling in Section	S T R	
	S T R	
3. Miscellaneous Property in Sec.	S T R	
	S T R	

Register of Deeds Stamp & File Number

4. Lot No. _____, Recorded Plat

5. Private Claims

I, Joseph C. Kapelczak, in a field survey on February 7, 1995, do hereby certify that under requirements of P.A. 74, Michigan P.A. of 1970, the corner points mentioned in lines 1 and 2 above were in conformance with regulations and rules therefore as required in the current manual of survey instructions of the United States Department of the Interior, Bureau of Land Management or by a decree of a Court of Law and/or that the corner points mentioned in lines 3, 4 and 5 above were in conformance with the rules of the Michigan Board of Land Surveyors or by a Decree of a Court of Law, established, re-established, monumented, re-monumented, recovered, found as expressed below:

	A	B	C	D	E	F	G	H	I	J	K	L
2	6		5		4		3		2			
3												
4	7		8		9		10		11			
5												
6	16		17		18		19		20			
7												
8	19		20		21		22		23			
9												
10	30		29		28		27		26			
11												
12	31		32		33		34		35			
13												

NOTE: Not more than 4 corners, all in the same town and range, may be recorded on this certificate.

A. Description of original monument and accessories and/or subsequent restoration:

Continued from previous page

LCRC L 7300 P 648
Stonerock 1989 Fd. 1/2" iron in box
N 45 W 83.67' Concrete monument
West 60.02' Cross in concrete
S 45 W 84.95' Cross on MBT manhole
rim at nearest point


LCRC L 11062 P 213
Donnelly 1989 Fd. 3/4" pipe in mon. box
North 12.03' 1/2" iron in mon. box
*N 31 E 107.39' Dbl. headed nail tag #17623 s. east face utility pole
*N 40 W 77.34' PK nail s. west face utility pole
S 67 E 84.34' N. west corner blue metal box on conc. base
S 43 E 66.34' Centerline top nut hydrant
*S 43 W 61.95' Dbl. headed nail tag #17623 south face utility pole:

LCRC L 11057 P 817
Roos 1989 Fd. 1/2" rerod in mon. box
*N 31 W 77.30' Fd. nail in power pole
*N 38 E 107.35' Fd. nail in power pole
S 65 E 81.43' Fd. nail in power pole
*S 50 W 61.94' Fd. nail in power pole

* Confirms LCRC witness

B. Description of corner evidence found and/or method applied in restoring or reestablishing corner:

C. Description of monument for corner and accessories established to perpetuate locating the position of the corner:

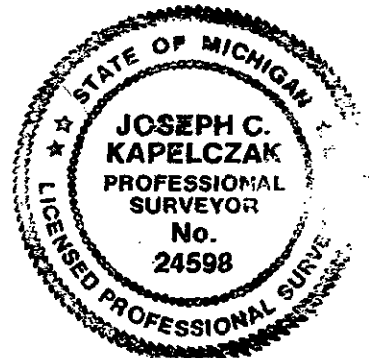

Signed by Joseph C. Kapelczak
Surveyors Michigan License No. 24598

Date 6/28/95