

JUL 19 95 129167

LIBER 15528 PG 787

LAND CORNER RECORDATION CERTIFICATE
Filing Requirement of Act 74, Mich. P.A. 1970

For corners in

Table with columns: Oakland (county), Located In, Corner Code #. Rows include Public Land Survey, Property Controlling in Section, and Miscellaneous Property in Sec.

\$ 7.00 MISCELLANEOUS RECORDING
\$ 2.00 REMONUMENTATION
19 JUL 95 2:06 P.M. RECEIPT# 71A
PAID RECORDED - OAKLAND COUNTY
LYNN D. ALLEN, CLERK/REGISTER OF DEEDS

Compliance with ACT 345, P.A. 1990

APPROVED ON: 7-12-95 [Signature]
OAKLAND COUNTY REMONUMENTATION PEER GROUP COMMITTEE

Register of Deeds Stamp & File Number

4. Lot No. _____, Recorded Plat _____

5. Private Claims _____

I, Joseph C. Kapelczak, in a field survey on February 7, 1995, do hereby certify that under requirements of P.A. 74, Michigan P.A. of 1970, the corner points mentioned in lines 1 and 2 above were in conformance with regulations and rules therefore as required in the current manual of survey instructions of the United States Department of the Interior, Bureau of Land Management or by a decree of a Court of Law and/or that the corner points mentioned in lines 3, 4 and 5 above were in conformance with the rules of the Michigan Board of Land Surveyors or by a Decree of a Court of Law; established, re-established, monumented, re-monumented, recovered, found as expressed below.

NOTE: Not more than 4 corners, all in the same town and range, may be recorded on this certificate.

A. Description of original monument and accessories and/or subsequent restoration:

Post set in 1816 G.O.L. survey: N 38 W 25lks, 18" Linden; S 60 W 14lks, 16" Linden.

LCRC L 5871 P 891
Jones 1972 Found 3/8" rerod
N 18 E 71.78' 27" Oak
S 40 W 23.31' 20" Oak
West 20.71' 18" Maple

B. Description of corner evidence found and/or method applied in restoring or reestablishing corner:


Recovered 1/2" rerod in monument box on centerline Haggerty Rd.

Recovered witnesses:
N 26 W 117.29' PK/tag #OCRC S.west side power pole
N 26 W 117.41" Nail tag #17623 northeast side power pole
N 77 W 78.79' Nail tag #17623 northeast side power pole
N 64 E 69.71' 1/2" rerod cap #33140(DPS)
N 42 E 84.03' PK tag #OCRC northwest side power pole
N 43 E 83.67' Nail tag #17623 southeast side power pole

C. Description of monument for corner and accessories established to perpetuate locating the position of the corner:

Set 5/8" rerod with O.C. Remonumentation brass cap replacing 1/2" rerod.

N 26 W 117.43' PK/remon tag northeast side power pole
N 77 W 86.60' PK/remon tag north side 10" dia. Maple
N 63 E 71.55' PK/remon tag north side 8" dia. Ash
N 48 E 102.07' PK/remon tag northwest side 6" dia. Maple

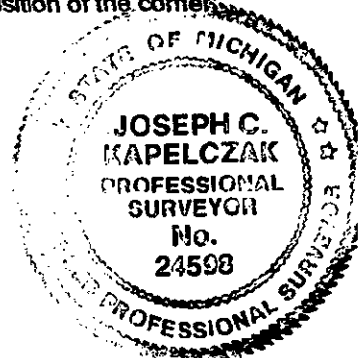

Signed by [Signature]
Surveyor's Michigan License No. 24598

Date 6/28/95