

COPY

LAND CORNER RECORDATION CERTIFICATE \$ 7.00 MISCELLANEOUS RECORDING  
Filing Requirement of Act 74, Mich. P.A. 1970 \$ 2.00 REMONUMENTATION

22 APR 96 10:23 A.M. RECEIPT# 168  
PAID RECORDED - OAKLAND COUNTY  
LYNN D. ALLEN, CLERK/REGISTER OF DEEDS

For corners in

Oakland (county)	Located In:	Corner Code #
1. Public Land Survey	T1N R8E	M-12
	T R	
	T R	
	T R	
2. Property Controlling in Section	S T R	
	S T R	
3. Miscellaneous Property in Sec.	S T R	
	S T R	

Compliance with  
ACT 345, P.A. 1990  
APPROVED ON: 7-12-95 OK T.S.  
OAKLAND COUNTY REMONUMENTATION  
PEER GROUP COMMITTEE

Register of Deeds Stamp & File Number

4. Lot No. \_\_\_\_\_, Recorded Plat

5. Private Claims

I, Joseph C. Kapelczak, in a field survey on March 13, 1995, do hereby certify that under requirements of P.A. 74, Michigan P.A. of 1970, the corner points mentioned in lines 1 and 2 above were in conformance with regulations and rules therefore as required in the current manual of survey instructions of the United States Department of the Interior, Bureau of Land Management or by a decree of a Court of Law and/or that the corner points mentioned in lines 3, 4 and 5 above were in conformance with the rules of the Michigan Board of Land Surveyors or by a Decree of a Court of Law; established, re-established, monumented, re-monumented, recovered, found as expressed below:

	A	B	C	D	E	F	G	H	I	J	K	L	M
2	6		5		4		3		2		1		
3													
4	7		8		9		10		11		12		
5													
6	18		17		16		15		14		13		
7													
8	19		20		21		22		23		24		
9													
10	30		29		28		27		26		25		
11													
12	31		32		33		34		35		36		
13													

NOTE: Not more than 4 corners, all in the same town and range, may be recorded on this certificate.

A. Description of original monument and accessories and/or subsequent restoration:

Post set in 1816 G.O.L. survey: N 47 W 46lks, 9"Liden; S 26 W 25lks, 8" Sugar.

NO LCRCs recorded

SURVEY & REMONUMENTATION

JUL 29 1996

COMMISSION

B. Description of corner evidence found and/or method applied in restoring or reestablishing corner:

Recovered 5/8" rerod in monument box on centerline Haggerty Rd.

Recovered witnesses:

- N 84 E 60.09' Nail tag #19834 s.east side power pole
- N 83 E 59.40' PK tag #46191(GW) north side power pole
- N 83 E 59.64' PK tag #14864 north side power pole
- S 33 W 63.29' PK tag #46190(GW) s.east side power pole
- S 33 W 63.10' Nail tag #OCRC s.east side power pole
- N 80 W 30.45' PK south side power pole
- N 80 W 30.75' Nail tag #OCRC south side power pole
- N 76 W 30.30' PK tag #OCRC north side power pole
- N 74 W 32.17' PK tag #46194(GW) north side power pole
- N 74 W 32.03' PK tag #14864 north side power pole


- N 88 W 71.81' 1/2" rerod (bent)
- N 89 W 31.19' Fence post, 4" wood southeast corner parcel #22-36-477-009

7.00  
2.00  
RV  
J.D.

C. Description of monument for corner and accessories established to perpetuate locating the position of the corner:

Set 5/8" rerod with O.C. Remonumentation brass cap replacing 5/8" rerod.

- N 83 E 59.60' PK/remon tag north side power pole
- S 33 W 63.10' PK/remon tag southeast side power pole
- N 74 W 31.89' PK/remon tag north side power pole
- N 82 W 52.70' PK /remon tag south side power pole

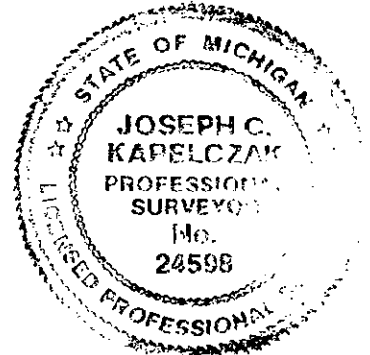

Signed by Joseph C. Kapelczak  
Surveyor's Michigan License No. 24598

Date 6/28/95