

FARM

LIBER 15528 PC 759

JUL 19 5 12 31 39
COPY

JUL 19 5 12 31 39

LAND CORNER RECORDATION CERTIFICATE
Filing Requirement of Act 74, Mich. P.A. 1970

For corners in

Oakland (county)	Located In:	Corner Code #
1. Public Land Survey	T1N R9E	A-9
	T R	
	T R	
	T R	
2. Property Controlling in Section	S T R	
	S T R	
3. Miscellaneous Property in Sec.	S T R	
	S T R	

\$ 7.00 MISCELLANEOUS RECORDING
 \$ 2.00 REMONUMENTATION
 19 JUL 95 2:02 P.M. RECEIPT# 71A
 PAID RECORDED - OAKLAND COUNTY
 LYNN D. ALLEN, CLERK/REGISTER OF DEEDS
 Compliance with
 ACT 345, P.A. 1990

APPROVED ON: 7-12-95 *Toms*
 OAKLAND COUNTY REMONUMENTATION
 PEER GROUP COMMITTEE
 Register of Deeds Stamp & File Number

4. Lot No. _____, Recorded Plat

5. Private Claims _____

I, Joseph C. Kapelczak, in a field survey on April 17, 1995, do hereby certify that under requirements of P.A. 74, Michigan P.A. of 1970, the corner points mentioned in lines 1 and 2 above were in conformance with regulations and rules therefore as required in the current manual of survey instructions of the United States Department of the Interior, Bureau of Land Management or by a decree of a Court of Law and/or that the corner points mentioned in lines 3, 4 and 5 above were in conformance with the rules of the Michigan Board of Land Surveyors or by a Decree of a Court of Law, established, re-established, monumented, re-monumented, recovered, found as expressed below:

NOTE: Not more than 4 corners, all in the same town and range, may be recorded on this certificate.

A. Description of original monument and accessories and/or subsequent restoration:

Post set in 1817 G.O.L. survey.

- LCRC L 5871 P 885
- Jones 1972 Fd. 1" steel iron
- S 26 E 65.30' Center top nut of hydrant
- N 55 E 62.66' Power pole
- S 55 E 58.93' Power pole
- N 50 W 55.08' Power pole

B. Description of corner evidence found and/or method applied in restoring or reestablishing corner:

Recovered an empty monument box at centerline of 10 Mile Rd. & Haggerty Rds.


Recovered witnesses:

- S 42 W 70.78' Nail tag #14623 southeast side power pole
- S 42 W 70.80' PK nail southeast side power pole
- N 40 W 68.01' PK nail southwest side power pole
- N 41 E 97.74' Nail southeast side power pole
- N 41 E 97.72' PK nail southeast side power pole
- N 41 E 97.59' Nail tag #17623 southeast side pole
- S 53 E 87.58' Nail tag #17623 south side power pole
- S 03 W 12.16' 5/8" pipe in monument box

C. Description of monument for corner and accessories established to perpetuate locating the position of the corner:

Set 5/8" rerod with O.C. Remonumentation brass cap.

- S 42 W 70.72' PK/remon tag southeast side power pole
- N 40 W 68.02' PK/remon tag southwest side power pole
- N 41 E 97.74' PK/remon tag southeast side power pole
- S 54 E 87.45' PK/remon tag north side power pole

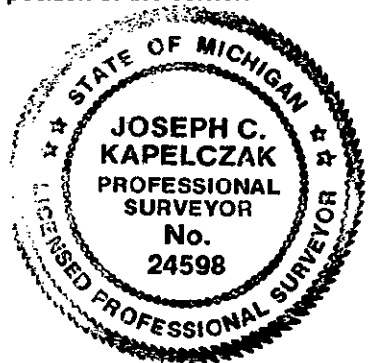

Signed by Joseph C. Kapelczak
 Surveyor's Michigan License No. 24598

Date 6/28/95