

APR 22 96 09 48 21

LIBER 16200 PAGE 320

COPY

LAND CORNER RECORDATION CERTIFICATE  
Filing Requirement of Act 74, Mich. P.A. 1970

\$ 7.00 MISCELLANEOUS RECORDING  
\$ 2.00 REMONUMENTATION  
22 APR 96 10:23 A.M. RECEIPT# 168  
PAID RECORDED - OAKLAND COUNTY  
LYNN D. ALLEN, CLERK/REGISTER OF DEEDS

For corners in

<u>Oakland</u> (county)	Located In:	Corner Code #
1. Public Land Survey	T1N R9E	A-13
	T___ R___	_____
	T___ R___	_____
	T___ R___	_____
2. Property Controlling in Section	S___ T___ R___	_____
	S___ T___ R___	_____
3. Miscellaneous Property in Sec.	S___ T___ R___	_____
	S___ T___ R___	_____

Compliance with  
ACT 345, P.A. 1981  
APPROVED ON: 7-12-95  
OAKLAND COUNTY REMONUMENTATION  
COMMISSION

Register of Deeds Stamp & File Number

4. Lot No. \_\_\_\_\_, Recorded Plat

5. Private Claims \_\_\_\_\_

I, Joseph C. Kapelczak, in a field survey on March 14, 1995, do hereby certify that under requirements of P.A. 74, Michigan P.A. of 1970, the corner points mentioned in lines 1 and 2 above were in conformance with regulations and rules therefore as required in the current manual of survey instructions of the United States Department of the Interior, Bureau of Land Management or by a decree of a Court of Law and/or that the corner points mentioned in lines 3, 4 and 5 above were in conformance with the rules of the Michigan Board of Land Surveyors or by a Decree of a Court of Law; established, re-established, monumented, re-monumented, recovered, found as expressed below:

A	B	C	D	E	F	G	H	I	J	K	L	M
2	6	5	4	3	2	1						
3												
4	7	8	9	10	11	12						
5												
6	16	17	18	15	14	13						
7												
8	19	20	21	22	23	24						
9												
10	30	29	28	27	26	25						
11												
12	31	32	33	34	35	38						
13												

NOTE: Not more than 4 corners, all in the same town and range, may be recorded on this certificate.

A. Description of original monument and accessories and/or subsequent restoration:

Post set in 1815 G.O.L. survey by Alexander Holmes (Michigan baseline).  
S 28 E 24lks, 16" Ash; S 35 W 22lks, 6" Elm.

No LCRCs recorded.

B. Description of corner evidence found and/or method applied in restoring or reestablishing corner:

Recovered 5/8" iron in monument box on centerline 8 Mile Rd. (in Blvd.)

Recovered witnesses:

- N 64 E 115.34' PK tag #00068(GW) southeast side power pole
- N 64 E 115.40' PK southeast side power pole
- N 64 W 155.20' PK tag #00067(GW) north side power pole
- N 64 W 155.19' PK north side power pole

SURVEY &  
REMONUMENTATION


JUL 29 1996

COMMISSION

C. Description of monument for corner and accessories established to perpetuate locating the position of the corner:

Set 5/8" rerod with O.C. Remonumentation brass cap replacing 5/8" iron.

- N 64 E 115.17' PK/remon tag southeast side power pole
- N 64 W 155.01' PK/remon tag north side power pole
- S 23 E 58.97' Chiseled cross on north rim G.V. & Well
- S 58 E 58.01' Chiseled cross on north rim G.V. & Well

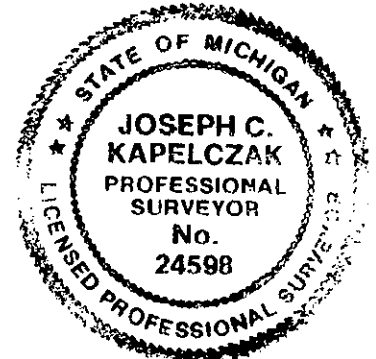

Signed by Joseph C. Kapelczak  
Surveyor's Michigan License No. 24598

Date 6/28/95