

**COPY**

LIBER 17932 PG 764

**LAND CORNER RECORDATION CERTIFICATE**  
Filing Requirement of Act 74, Mich. P.A. 1970

For corners in

Oakland Located In: Farmington Twp. Corner Code #  
(County)

1. Public Land Survey	T <u>1</u> -N <u>9</u> E	B-11
	T _____ R _____	
	T _____ R _____	
	T _____ R _____	
2. Property Controlling in Section	S _____ T _____ R _____	<b>SURVEY &amp; REMONUMENTATION</b>
3. Miscellaneous Property in Sec.	S _____ T _____ R _____	
	S _____ T _____ R _____	<b>MAR 21 2000</b>

**\$ 7.00 MISCELLANEOUS RECORDING**  
**\$ 2.00 REMONUMENTATION**  
 2 JAN 98 9:01 A.M. RECEIPT# 12A  
 PAID in accordance with **OAKLAND COUNTY**  
 LYNN D. ALLEN, CLERK/REGISTER OF DEEDS  
 APPROVED ON: **1-20-98**  
**OAKLAND COUNTY REMONUMENTATION**  
**PEER GROUP COMMITTEE**  
 Register of Deeds Stamp & File Number

4. Lot No. \_\_\_\_\_, Recorded Plat \_\_\_\_\_ **SECTION** \_\_\_\_\_  
 5. Private Claims \_\_\_\_\_

I, John N. Redash in a field survey on March 6 do hereby state that under requirements of P.A. 74, Michigan P.A. of 1970, the corner points mentioned in lines 1 and 2 above were in conformance with regulations and rules therefore as required in the current manual of survey instructions of the United States Department of the Interior, Bureau of Land Management or by a decree of a Court of Law and /or that the corner points mentioned in lines 3, 4 and 5 above were in conformance with the rules of the Michigan Board of Land Surveyors or by a Decree of a Court of Law; established, re-established, monumented, recovered, found as expressed below:

**NOTE:** Not more than 2 corners, all in the same town and range, may be recorded on this certificate.

A	B	C	D	E	F	G	H	I	J	K	L
1											
2	6		5		4		3		2		1
3											
4	7		8		9		10		11		12
5											
6	18		17		16		15		14		13
7											
8	19		20		21		22		23		24
9											
10	30		29		28		27		26		25
11	●										
12	31		32		33		34		35		36
13											


**A. Description of original monument and accessories and/or subsequent restoration:**

1817 Set post	S. Carpenter	n/a	G.L.O. Notes
1977 Iron pipe in 9 Mile	T. Wozniak	#15066	L.C.R.C. L 7000 p. 840
1988 Not described	T. Wozniak	#15066	Survey L 10878 p 008

**B. Description of corner evidence found and/or method applied in restoring or reestablishing corner:**

A 1/2" iron in monument box currently occupies this corner. Current measurements match one tie from L.C.R.C. L 7000 p. 840. Field measurements were obtained between the following corners:

B-11 to C-11	A-11 to B-11
2651.70 meas.	2571.48 meas.
2640.00 Rec G.L.O.	2559.48 Rec. G.L.O.
2651.38 Rec Plats L159 p. 28-31 and Tax maps	2571.85 Rec. Plats L167, P33-36 and Tax Maps
	2571.43 Rec. M.D.O.T. ROW plans 63R-1 Sheet 251

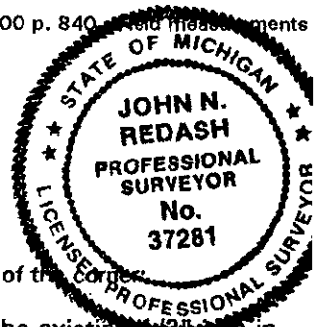

**C. Description of monument for corner and accessories established to perpetuate locating the position of the corner:**

1 Placed a 2" diameter brass cap stamped "Oakland County Remonumentation PS 37281" on the existing monumentation box. Witnesses are as follows:

N 47° W.,	95.55'	P.K. nail and remon. washer	S. face 6" Elm
N 5° W.,	58.98'	P.K. nail and remon. washer	W. face U-Pole
N 70° E.,	98.10	P.K. nail and remon. washer	S. face twin 12" Walnut
S 15° E.,	34.00	Centerline top nut fire hydrant	

The selected location is accepted by me and generally accepted by Professional Surveyors as the best available evidence of the position of the original corner.

Signed by John N. Redash Date April 24, 1997  
 Surveyor's Michigan License No. 37281