

LAND CORNER RECORDATION CERTIFICATE
Filing Requirement of Act 74, Mich. P.A. 1970

For corners in

Oakland
(County)

Located In: Farmington Twp. Corner Code #

1. Public Land Survey

T 1-N R 9-E D-7

2. Property Controlling in Section

S T R

3. Miscellaneous Property in Sec.

S T R
S T R

SURVEY & REMONUMENTATION

MAR 21 2000

SECTION

4. Lot No. _____, Recorded Plat _____

5. Private Claims _____

I, John N. Redash, in a field survey on March 6, 1997, do hereby state that under requirements of P.A. 74, Michigan P.A. of 1970, the corner points mentioned in lines 1 and 2 above were in conformance with regulations and rules therefore as required in the current manual of survey instructions of the United States Department of the Interior, Bureau of Land Management or by a decree of a Court of Law and /or that the corner points mentioned in lines 3, 4 and 5 above were in conformance with the rules of the Michigan Board of Land Surveyors or by a Decree of a Court of Law; established, re-established, monumented, recovered, found as expressed below:

NOTE: Not more than 2 corners, all in the same town and range, may be recorded on this certificate.

\$ 7.00 MISCELLANEOUS RECORDING
\$ 2.00 REMONUMENTATION
2 JAN 98 9:02 A.M. RECEIPT# 12A
PAID RECORDED - OAKLAND COUNTY
LYNN D. ALLEN, CLERK REGISTER OF DEEDS
APPROVED ON: 4-28-97 15
OAKLAND COUNTY REMONUMENTATION
PEER GROUP COMMITTEE
Register of Deeds Stamp & File Number

	A	B	C	D	E	F	G	H	I	J	K	L
1												
2	6		5		4		3		2		1	
3												
4	7		8		9		10		11		12	
5												
6	18		17		16		15		14		13	
7												
8	19		20		21		22		23		24	
9												
10	30		29		28		27		26		25	
11												
12	31		32		33		34		35		36	
13												

A. Description of original monument and accessories and/or subsequent restoration:

1817	Set post	S. Carpenter	N/A	G.L.O. notes
1976	Found iron	K. Wilkerson	#21584	L.C.R.C. L6731, P126
1994	Found 1/2" iron pipe in monument box	G. Platz	#38121	L.C.R.C. L15176, P208

B. Description of corner evidence found and/or method applied in restoring or reestablishing corner:


A 1/2" iron in a monument box in the approximate centerline of Eleven Mile Road and approximately 185' west of centerline of Old Homestead Road occupies this corner. The following witness ties were used to recover and verify its position:

Four current measurements match ties from L.C.R.C. L15176, P208
Field measurements were made between the following corners:
C-7 to D-7 D-7 to E-7
2606.25 meas. 2633.15 meas.
2615.58 G.L.O. 2615.58 G.L.O.
2605.88 Tax maps 2634.66 Plats L83, P38 & L79, P13

C. Description of monument for corner and accessories established to perpetuate locating the position of the corner:

I placed a 2" diameter brass cap stamped "Oakland County Remonumentation P.S. #37281" on the existing 1/2" iron rod in monument box. Witnesses are as follows:

S. 45° E.,	56.40'	Set P.K. nail and remon. washer N.E. face 12" Basswood
S. 70° W.,	85.45'	Set P.K. nail and remon. washer S. face 12" Elm
N. 47° W.,	71.98'	Set P.K. nail and remon. washer W. face 24" Cottonwood
N. 10° W.,	35.55'	Set P.K. nail and remon. washer W. face twin 15" Ash

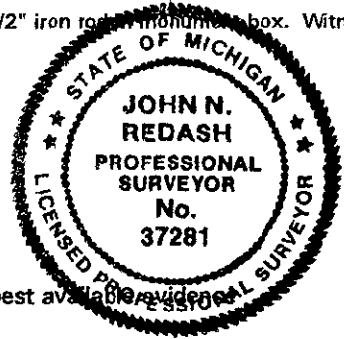

The selected location is accepted by me and generally accepted by Professional Surveyors as the best available evidence of the position of the original corner.

Signed by John N. Redash
Surveyor's Michigan License No. 37281

Date April 24, 1997