

LIBER 17932 PG 775  
**LAND CORNER RECORDATION CERTIFICATE**  
 Filing Requirement of Act 74, Mich. P.A. 1970

JA-2 98 000223

For corners in

Oakland

COPY

Located In: Farmington Twp. Corner Code # \_\_\_\_\_

1. Public Land Survey T 1-N R 9-E \_\_\_\_\_ D-11  
 T \_\_\_\_\_ R \_\_\_\_\_  
 T \_\_\_\_\_ R \_\_\_\_\_  
 T \_\_\_\_\_ R \_\_\_\_\_

2. Property Controlling S \_\_\_\_\_ T \_\_\_\_\_ R \_\_\_\_\_  
 in Section S \_\_\_\_\_ T \_\_\_\_\_ R \_\_\_\_\_

3. Miscellaneous S \_\_\_\_\_ T \_\_\_\_\_ R \_\_\_\_\_  
 Property in Sec. S \_\_\_\_\_ T \_\_\_\_\_ R \_\_\_\_\_

SURVEY &  
REMONUMENTATION

MAR 21 2000

SECTION

\$ 7.00 MISCELLANEOUS RECORDING  
 \$ 2.00 REMONUMENTATION  
 2 JAN 98 9:02 A.M. RECEIPT# 12A  
 PAID RECORDED IN OAKLAND COUNTY  
 LYNN D. ALLEN, CLERK/REGISTER OF DEEDS  
 APPROVED ON: 4-28-97 JS  
 OAKLAND COUNTY REMONUMENTATION  
 PEER GROUP COMMITTEE  
 Register of Deeds Stamp & File Number

4. Lot No. \_\_\_\_\_, Recorded Plat \_\_\_\_\_

5. Private Claims \_\_\_\_\_

I, John N. Redash, in a field survey on March 6, 1997 do hereby state that under requirements of P.A. 74, Michigan P.A. of 1970, the corner points mentioned in lines 1 and 2 above were in conformance with regulations and rules therefore as required in the current manual of survey instructions of the United States Department of the Interior, Bureau of Land Management or by a decree of a Court of Law and /or that the corner points mentioned in lines 3, 4 and 5 above were in conformance with the rules of the Michigan Board of Land Surveyors or by a Decree of a Court of Law; established, re-established, monumented, recovered, found as expressed below:

**NOTE:** Not more than 2 corners, all in the same town and range, may be recorded on this certificate.

	A	B	C	D	E	F	G	H	I	J	K	L	M
1													
2	6		5		4		3		2		1		
3													
4	7		8		9		10		11		12		
5													
6	18		17		16		15		14		13		
7													
8	19		20		21		22		23		24		
9													
10	30		29		28		27		26		25		
11													
12	31		32		33		34		35		36		
13													

**A. Description of original monument and accessories and/or subsequent restoration:**

1817 Set post	S. Carpenter	n/a	GLO notes
1941 Not described	G. Jerome & Co.	n/a	Unrecorded survey
1977 1/2" iron bar in monument box	D. Vitinis	#17324	LCRC L6889, P404, 405
1977 Not described	F. Papke	#9675	Survey L7026, P321
1977 Not described	T. Parish	#24609	Survey L7141, P125
1978 Found iron in monument box	T. parish	#24609	L.C.R.C. L7353, P26

**B. Description of corner evidence found and/or method applied in restoring or reestablishing corner:**

A 1/2" iron in monument box currently occupies this corner. Current measurements match one tie each from L.C.R.C. L6889, P404, 405 and L7353, P26. Field measurements were made between the following corners:

C-11 to D-11	D-11 to E-11
2628.52 meas.	2626.74 meas.
2612.94 Rec. G.L.O.	2612.94 G.L.O.
2628.51 Rec. Survey L7141, P125	2626.67 Unrecorded survey G. Jerome & Co.
	2627.24 Unrecorded survey D. Ross #19005

**C. Description of monument for corner and accessories established to perpetuate locating the position of the corner:**


I placed a 2" diameter brass cap stamped "Oakland County Remonumentation PS#37281" on the existing 1/2" iron in monument box. Witness ties are as follows:

S. 5° W.,	61.08'	P.K. nail and remon. washer E. face U-pole
S. 50° W.,	62.16'	Centerline water gate and valve
N. 10° W.,	58.44'	P.K. nail and remon. washer W. face U-pole
S. 10° E.,	63.49'	Concrete monument
N. 60° E.,	173.34'	Concrete monument

The selected location is accepted by me and generally accepted by Professional Surveyors as the best available evidence of the position of the original corner.

Signed by John N. Redash  
 Surveyor's Michigan License No. 37281

Date April 28, 1997

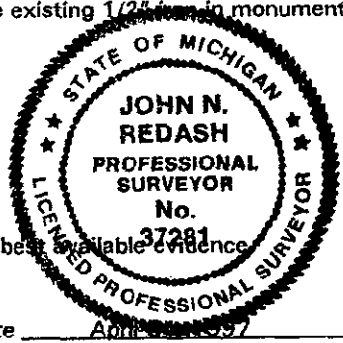

700 FILE  
200