

LAND CORNER RECORDATION CERTIFICATE
Filing Requirement of Act 74, Mich. P.A. 1970

For corners in

Oakland
(County)

Located in: Farmington Twp. Corner Code #

1. Public Land Survey

T. 1-N R. 9-E G-8

T. R.

T. R.

T. R.

2. Property Controlling in Section

S. T. R.

S. T. R.

3. Miscellaneous Property in Sec.

S. T. R.

S. T. R.

SURVEY &
REMONUMENTATION

MAR 21 2000

SECTION

4. Lot No. _____, Recorded Plat _____

5. Private Claims _____

I, John N. Redash, in a field survey on March 24, 1997 do hereby state that under requirements of P.A. 74, Michigan P.A. of 1970, the corner points mentioned in lines 1 and 2 above were in conformance with regulations and rules therefore as required in the current manual of survey instructions of the United States Department of the Interior, Bureau of Land Management or by a decree of a Court of Law and for that the corner points mentioned in lines 3, 4 and 5 above were in conformance with the rules of the Michigan Board of Land Surveyors or by a Decree of a Court of Law; established, re-established, monumented, recovered, found as expressed below:

NOTE: Not more than 2 corners, all in the same town and range, may be recorded on this certificate.

A. Description of original monument and accessories and/or subsequent restoration:

1817 Post S. Carpenter n/a GLO notes
No L.C.R.C.'s have been recorded as of this date

B. Description of corner evidence found and/or method applied in restoring or reestablishing corner:

No point was found marking this corner. I re-established this corner by measurements within Ridgewood Subdivision, Liber 56, Page 38-40 along Ridgewood Drive. Field measurements were then obtained between the following corners:

G-7 to G-8	G-8 to G-9
2644.47 meas.	2646.30 meas.
2640.00 Rec. G.L.O.	2640.00 Rec. G.L.O.
2645.20 Rec. Plat L56, P38-40	2644.44 Rec. Unrecorded.
	Survey and Tax map

C. Description of monument for corner and accessories established to perpetuate locating the position of the corner:

I placed a 5/8" x 24" iron rod with a brass cap stamped "Oakland County Remonumentation PS#37281" in a new monument box in asphalt pavement. Witnesses are as follows:


S. 80° E., 35.62'	Cut cross north rim sanitary MH
S. 45° E., 58.72'	Centerline top nut fire hydrant
S. 10° W., 102.84'	P.K. nail and remon. washer E. face 8" Twin Elm
N. 15° W., 96.54'	P.K. nail and remon. washer E. face 8" Twin Elm

The selected location is accepted by me and generally accepted by Professional Surveyors as the best available evidence of the position of the original corner.

Signed by John N. Redash

Date March 24, 1997

Surveyor's Michigan License No. 37281

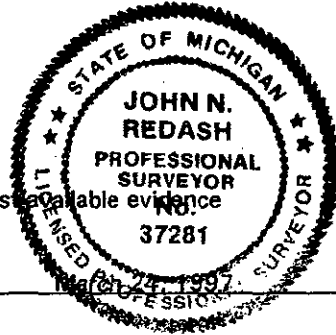

JA-298000237

Compliance with ACT 345, P.A. 1990
APPROVED ON: 5-19-97 TS
OAKLAND COUNTY REMONUMENTATION PEER GROUP COMMITTEE
\$ 7.00 MISCELLANEOUS RECORDING
\$ 2.00 RE-MONUMENTATION
2 JAN 98 9:04 A.M. RECEIPT# 12A
PAID RECORDED - OAKLAND COUNTY
LYNN B. ALLEN, CLERK/REGISTER OF DEEDS

1						
2	6	5	4	3	2	1
3						
4	7	8	9	10	11	12
5						
6	18	17	16	15	14	13
7						
8	19	20	21	22	23	24
9						
10	30	29	28	27	26	25
11						
12	31	32	33	34	35	36
13						