

LIBER 17932 PG 790

LAND CORNER RECORDATION CERTIFICATE
Filing Requirement of Act 74, Mich. P.A. 1970

For corners in

Oakland (County)

Located In: Farmington Twp. Corner Code #

1. Public Land Survey T 1-N R 9-E G-9
2. Property Controlling in Section S T R SURVEY & REMONUMENTATION
3. Miscellaneous Property in Sec. S T R MAR 21 2000

4. Lot No. , Recorded Plat SECTION
5. Private Claims

I, John N. Redash, in a field survey on March 10, 1997 do hereby state that under requirements of P.A. 74, Michigan P.A. of 1970, the corner points mentioned in lines 1 and 2 above were in conformance with regulations and rules therefore as required in the current manual of survey instructions of the United States Department of the Interior, Bureau of Land Management or by a decree of a Court of Law and /or that the corner points mentioned in lines 3, 4 and 5 above were in conformance with the rules of the Michigan Board of Land Surveyors or by a Decree of a Court of Law; established, re-established, monumented, recovered, found as expressed below:

NOTE: Not more than 2 corners, all in the same town and range, may be recorded on this certificate.

A. Description of original monument and accessories and/or subsequent restoration:

Table with 4 columns: Year, Description, Name, and Notes. Includes entries for 1817 Set post, 1941 Concrete monument, 1988 Concrete monument, and 1990 Concrete monument.

B. Description of corner evidence found and/or method applied in restoring or reestablishing corner:

A found concrete monument at Twin Valley Subdivision, as recorded in L92, P26, currently occupies this corner. Current measurements match 3 ties from L.C.R.C., L11270, P300. Field measurements were obtained between the following corners:

Table with 4 columns: Corner Pair, Measurement, Corner Pair, Measurement. Lists measurements between corners G-8 to G-9, G-9 to F-9, G-9 to G-10, and G-9 to H-9.

C. Description of monument for corner and accessories established to perpetuate locating the position of the corner:


I left the found concrete monument undisturbed. Witnesses are as follows:

- N. 45° E., 33.50' P.K. Nail and remon. washer S.E. face 15" Sassafrass
S. 80° E., 65.66' P.K. Nail and remon. washer S.W. face U-Pole
S. 35° E., 10.17' P.K. Nail and remon. washer W. face U-Pole
Due South, 73.07' P.K. Nail and remon. washer W. face U-pole

The selected location is accepted by me and generally accepted by Professional Surveyors as the best available evidence of the position of the original corner.

Signed by John N. Redash
Surveyor's Michigan License No. 37281

Date March 24, 1998

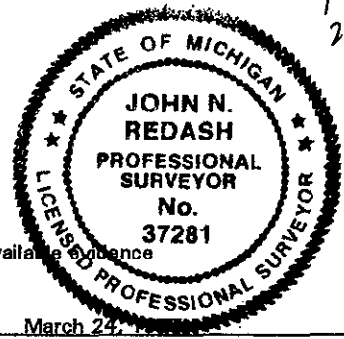

Compliance with ACT 345, P.A. 1990
APPROVED ON: 5-19-97 rs
OAKLAND COUNTY REMONUMENTATION \$ 7.00 MISCELLANEOUS RECORDING \$ 2.00
2 JAN 98 9:05 A.M. RECEIPT# 12A
PAID RECORDED - OAKLAND COUNTY
LYNN D. ALLEN, CLERK/REGISTER OF DEEDS

