

LIBER 17932PG792

LAND CORNER RECORDATION CERTIFICATE
Filing Requirement of Act 74, Mich. P.A. 1970

For corners in

Oakland (County)

Located In: Farmington Twp. Corner Code #

1. Public Land Survey T 1-N R 9-E G-11
T R
T R
T R
2. Property Controlling in Section S T R
S T R
3. Miscellaneous Property in Sec. S T R
S T R

SURVEY & REMONUMENTATION

MAR 21 2000

Compliance with ACT 345, P.A. 1990

APPROVED ON: 5-19-97 BY OAKLAND COUNTY REMONUMENTATION PEER GROUP COMMITTEE

\$ 7.00 MISCELLANEOUS RECORDING


\$ 2.00 REMONUMENTATION

2 JAN 98 9:05 A.M. RECEIPT# 12A PAID RECORDED - OAKLAND COUNTY LYNN B. NELSON, CLERK/REGISTER OF DEEDS

4. Lot No. , Recorded Plat SECTION
5. Private Claims

I, John N. Redash, in a field survey on March 4, 1997 do hereby state that under requirements of P.A. 74, Michigan P.A. of 1970, the corner points mentioned in lines 1 and 2 above were in conformance with regulations and rules therefore as required in the current manual of survey instructions of the United States Department of the Interior, Bureau of Land Management or by a decree of a Court of Law and /or that the corner points mentioned in lines 3, 4 and 5 above were in conformance with the rules of the Michigan Board of Land Surveyors or by a Decree of a Court of Law; established, re-established, monumented, recovered, found as expressed below:

NOTE: Not more than 2 corners, all in the same town and range, may be recorded on this certificate.

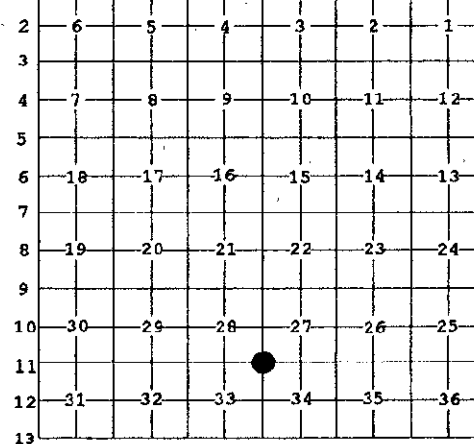

A. Description of original monument and accessories and/or subsequent restoration:

Table with 5 columns: Year, Description, Surveyor, ID Number, and G.L.O. Notes. Rows include 1817 Set post corner, 1975 Iron pipe in monument box, 1977 Not described, 1978 Found iron in monument box, 1978 Not described, 1979 Found 1" pipe in monument box.

B. Description of corner evidence found and/or method applied in restoring or reestablishing corner:

A 1" pipe in monument box currently occupies this corner. Current measurements match two ties each from L.C.R.C. L6479, P160, survey L7147, P139, and L.C.R.C. L7716, P210. Field measurements were made between the following corners:

Table with 4 columns listing corner connections and measurements: G-10 to G-11, F-11 to G-11, G-11 to H-11, G-11 to G-12.

C. Description of monument for corner and accessories established to perpetuate locating the position of the corner:

I replaced the 1" pipe with a 5/8" x 24" iron with a 2" diameter brass cap stamped "Oakland County Remonumentation PS 37281 in the monument box.

Witnesses are as follows: N. 65° E., 71.55'; S. 50° E., 62.97'; S. 25° W., 85.14'; N. 45° W., 56.55'; P.K. nail and remon. washer S.E. face U-Pole; P.K. nail and remon. washer N.E. face U-Pole; Centerline top nut of fire hydrant; P.K. nail and remon. washer N.E. face U-Pole

The selected location is accepted by me and generally accepted by Professional Surveyors as the best available evidence of the position of the original corner.

Signed by John N. Redash, Surveyor's Michigan License No. 37281

Date April 24, 1997

