

LIBER 17932 PG 795

LAND CORNER RECORDATION CERTIFICATE
Filing Requirement of Act 74, Mich. P.A. 1970

For corners in

Oakland (County)

Located In: Farmington Twp. Corner Code #

1. Public Land Survey T 1-N R 9-E G-13
 T _____ R _____
 T _____ R _____
 T _____ R _____

2. Property Controlling in Section S _____ T _____ R _____
 S _____ T _____ R _____

3. Miscellaneous Property in Sec. S _____ T _____ R _____
 S _____ T _____ R _____

SURVEY & REMONUMENTATION

MAR 21 2000

4. Lot No. _____, Recorded Plat _____ SECTION _____

5. Private Claims _____

I, John N. Redash, in a field survey on March 6, 1997 do hereby state that under requirements of P.A. 74, Michigan P.A. of 1970, the corner points mentioned in lines 1 and 2 above were in conformance with regulations and rules therefore as required in the current manual of survey instructions of the United States Department of the Interior, Bureau of Land Management or by a decree of a Court of Law and /or that the corner points mentioned in lines 3, 4 and 5 above were in conformance with the rules of the Michigan Board of Land Surveyors or by a Decree of a Court of Law; established, re-established, monumented, recovered, found as expressed below:

NOTE: Not more than 2 corners, all in the same town and range, may be recorded on this certificate.

A. Description of original monument and accessories and/or subsequent restoration:

1816 Set post corner J. Wampler n/a G.L.O. Notes

B. Description of corner evidence found and/or method applied in restoring or reestablishing corner:

A found pipe in concrete in monument box currently occupies this corner. No L.C.R.C.'s or surveys are on record.


F-13 to G13 2705.31 meas. 2640.00 Rec. G.L.O. 2702.65 Rec. Tax maps	G-12 to G13 2649.70 meas. 2640.00 Rec. G.L.O. 2648.14 Rec. Tax maps 2648.66 Rec. Plats L104, P28	G-13 to G-1 (T-1-S, R-9-E) 59.40 meas. 21.12 Rec. G.L.O.	G13 to H-13 2632.97 meas. 2640.00 Rec. G.L.O. 2633.30 Rec. Plats L57, P54 & L94, P32
--	--	--	---

C. Description of monument for corner and accessories established to perpetuate locating the position of the corner:

I placed a 2" diameter brass cap stamped "Oakland County Remonumentation PS 37281" on the existing pipe in concrete in monument box.

Witnesses are as follows:

N. 45° W., 110.92'	P.K. nail and remon. Washer Northeast face of guy pole
N. 30° E., 50.74'	P.K. nail and remon. Washer West face of U-Pole
S. 10° E., 51.62'	North anchor bolt on traffic light base
S. 60° W., 110.27'	Northeast anchor bolt on traffic light base
Due West 59.40	Centerline monument box (G-1) (T-1-S, R-9-E)

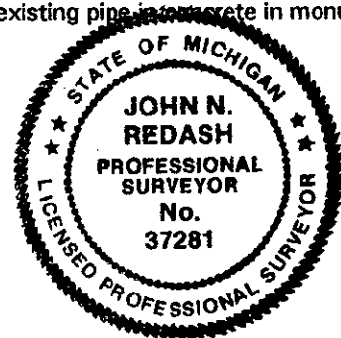

The selected location is accepted by me and generally accepted by Professional Surveyors as the best available evidence of the position of the original corner.

Signed by John N. Redash

Date April 24, 1997

Surveyor's Michigan License No. 37281

JA-298000743

Compliance with ACT 345, P.A. 1990

APPROVED ON: 5-19-97 - JS

OAKLAND COUNTY REMONUMENTATION
PEER GROUP COMMITTEE

\$ 7.00 MISCELLANEOUS RECORDING
\$ 2.00 REMONUMENTATION

2 JAN 98 9:05 A.M. RECEIPT# 12A
PAID RECORDED - OAKLAND COUNTY
LYNN D. ALLEN, CLERK/REGISTER OF DEEDS

2	6	5	4	3	2	1
3						
4	7	8	9	10	11	12
5						
6	18	17	16	15	14	13
7						
8	19	20	21	22	23	24
9						
10	30	29	28	27	26	25
11						
12	31	32	33	34	35	36
13						

FILE