

LIBER 17932 PC 793

LAND CORNER RECORDATION CERTIFICATE
Filing Requirement of Act 74, Mich. P.A. 1970

For corners in

Oakland (County)

Located In: Farmington Twp. Corner Code #

1. Public Land Survey

T 1-N R 9-E H-7

T R

T R

T R

2. Property Controlling in Section

S T R

S T R

3. Miscellaneous Property in Sec.

S T R

S T R

SURVEY & REMONUMENTATION

MAR 21 2000

SECTION

4. Lot No. , Recorded Plat

5. Private Claims

I, John N. Redash, in a field survey on March 6, 1997, do hereby state that under requirements of P.A. 74, Michigan P.A. of 1970, the corner points mentioned in lines 1 and 2 above were in conformance with regulations and rules therefore as required in the current manual of survey instructions of the United States Department of the Interior, Bureau of Land Management or by a decree of a Court of Law and/or that the corner points mentioned in lines 3, 4 and 5 above were in conformance with the rules of the Michigan Board of Land Surveyors or by a Decree of a Court of Law; established, re-established, monumented, recovered, found as expressed below:

NOTE: Not more than 2 corners, all in the same town and range, may be recorded on this certificate.

A. Description of original monument and accessories and/or subsequent restoration:

1816 Set post corner J. Wampler n/a GLO notes
1989 No reference D. Ross #19005 Unrecorded survey

B. Description of corner evidence found and/or method applied in restoring or reestablishing corner:


A found 1/2" iron in an existing monument box at the intersection of Powers Road and Eleven Mile Road currently occupies this corner. No L.C.R.C.s have been recorded to date. Field observations were obtained between the following corners:

G-7 to H-7 H-7 to I-7
2650.92 Meas. 2621.63 Meas.
2650.94 Rec. Unrecorded Survey D. Ross #19005 2621.62 Rec. Plats L35, P42 & Supervisor's Muer Farms

C. Description of monument for corner and accessories established to perpetuate locating the position of the corner:

I placed a 2" diameter brass cap stamped "Oakland County Remonumentation PS#37281" on the existing 1/2" iron in existing monument box. Witness ties are as follows:

N. 40° E., 61.08' P.K. nail and remon. tag N.W. face U-pole
S. 30° E., 96.91' P.K. nail and remon. tag W. face Twin 24" Elm
S. 45° W., 73.39' P.K. nail and remon. tag N.W. face U-pole
N. 35° W., 54.18' P.K. nail and remon. tag S.W. face 18" Elm
S. 45° E., 66.91' Found steel clad monument

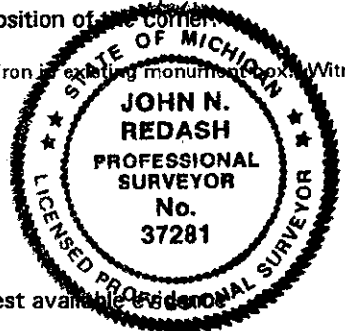

The selected location is accepted by me and generally accepted by Professional Surveyors as the best available evidence of the position of the original corner.

Signed by John N. Redash
Surveyor's Michigan License No. 37281

Date March 24, 1997

Compliance with ACT 345, P.A. 1990
APPROVED ON: 5-19-97 JS
OAKLAND COUNTY REMONUMENTATION PEER GROUP COMMITTEE

Table with columns for recording fees and a grid for recording details. Includes entries for \$7.00 MISCELLANEOUS RECORDING, \$2.00 REMONUMENTATION, and recording date 2 JAN 98 9:05 A.M. RECEIPT# 12A.