

SURVEY & REMONUMENTATION

LIBER **16848** PG **768**

Dec 18 96 305709

MAY 2 2 1997

LAND CORNER RECORDATION CERTIFICATE
 Filing Requirement of Act 74, Mich. P.A. 1970

\$ 7.00 MISCELLANEOUS RECORDING
 \$ 2.00 REMONUMENTATION
 PAID RECEIPT# 358
 RECORDED - OAKLAND COUNTY
 LYNN D. ALLEN, CLERK/REGISTER OF DEEDS

COMMISSION


For corners in

<u>Oakland</u> (County)	Located in: Farmington Corner Code # Township
1. Public Land Survey	T <u>1N</u> R <u>9E</u> <u>1-7</u>
	T _____ R _____
	T _____ R _____
	T _____ R _____
2. Property Controlling in Section	S _____ T _____ R _____
	S _____ T _____ R _____
3. Miscellaneous Property in Sec.	S _____ T _____ R _____
	S _____ T _____ R _____

Compliance with ACT 345, P.A. 1990
 APPROVED ON: 10-23-96 YS
 OAKLAND COUNTY REMONUMENTATION PEER GROUP COMMITTEE
 Register of Deeds Stamp & File Number

4. Lot No. _____, Recorded Plat _____
 5. Private Claims _____

I, Randy Kolehouse, in a field survey on September 2 19 96, do hereby certify that under requirements of P.A. 74 Michigan P.A. of 1970, the corner points mentioned in lines 1 and 2 above were in conformance with regulations and rules therefore as required in the current manual of survey instructions of the United States Department of the interior, Bureau of Land Management or by a decree of a Court of Law and/or that the corner points mentioned in lines 3, 4 and 5 above were in conformance with the rules of the Michigan Board of Land Surveyors or by a Decree of a Court of Law; established, re-established, monumented, re-monumented, recovered, found as expressed below:

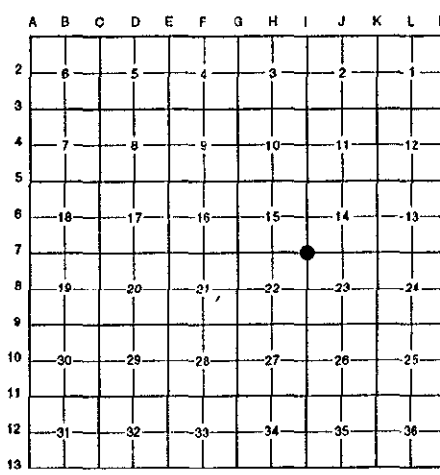

NOTE: Not more than 4 corners, all in the same town and range, may be recorded on this certificate.

A. Description of original monument and accessories and/or subsequent restoration:
 I-7 1817 Wampler G.L.O. Set Post
 1952 Johnson Supervisor's Plat No. 14 L. 69 P. 1 N/A

B. Description of corner evidence found and/or method applied in restoring or reestablishing corner:
 I-7 Found a 3/8" iron in a monument box on the C/L of 11 Mile Road running East and West and 28' West of the C/L of Orchard Lake Road running North and South. This corner checks closely the distance South to I-8 as shown in Supervisor's Plat No. 14 L. 69 P. 1 (1952). Found no other information on record.

Measure South 2667.97' to I-8 (G.L.O. = 2640.0') (Supervisor's Plat No. 14 = 2668.68')
 Measure East 2630.41' to J-7 (G.L.O. = 2623.5') (Springbrook Sub. No. 2 L. 58 P. 50 = 2633.7')

C. Description of monument for corner and accessories established to perpetuate locating the position of the corner:
 I-7 Replaced the 3/8" iron with a 5/8" x 24" rebar with brass cap stamped "Oakland County Remonumentation P.S. #25854" in an existing monument box.
 Set PK Nail & Tag Stamped "Oakland Co. Remonumentation P.S. #25854" in SW Side Util. Pole S 28° E 113.79'
 Set PK Nail & Tag Stamped "Oakland Co. Remonumentation P.S. #25854" in NE Side Util. Pole N 32° W 88.14'
 Set PK Nail & Tag Stamped "Oakland Co. Remonumentation P.S. #25854" in SE Side Util. Pole N 70° E 87.66'
 E'ly Most Cor. Brick Sign/Wall "City of Farmington Hills" S 45° W 96.89'
 C/L Inter. of 11 Mile Road and Orchard Lake N 90° E 28' ±

The selected location is accepted by the Contractor and is generally accepted by professional surveyors as the best available evidence of the position of the original corner.

Signed by Randy J. Kolehouse Date 12/10/96
 EARTH TECH
 Surveyor's Michigan License No. 25854

