

MAY 22 1997

COMMISSION

LAND CORNER RECORDATION CERTIFICATE

Filing Requirement of Act 74, Mich. P.A. 1970 \$ 7.00 MISCELLANEOUS RECORDING

For corners in

Oakland (County)

Located in: Farmington Corner Code # Township

\$ 2.00 REMONUMENTATION
18 DEC 96 1:36 P.M. RECEIPT# 358
PAID RECORDED - OAKLAND COUNTY
LYNN D. ALLEN, CLERK/REGISTER OF DEEDS

Compliance with ACT 345, P.A. 1990


APPROVED ON: 10-23-96 TS
OAKLAND COUNTY REMONUMENTATION
PEER GROUP COMMITTEE
Register of Deeds Stamp & File Number

- 1. Public Land Survey T 1N R 9E I-11
2. Property Controlling in Section S T R
3. Miscellaneous Property in Sec. S T R

- 4. Lot No. Recorded Plat
5. Private Claims

I, Randy Kolehouse, in a field survey on September 2, 1996, do hereby certify that under requirements of P.A. 74 Michigan P.A. of 1970, the corner points mentioned in lines 1 and 2 above were in conformance with regulations and rules therefore as required in the current manual of survey instructions of the United States Department of the interior, Bureau of Land Management or by a decree of a Court of Law and/or that the corner points mentioned in lines 3, 4 and 5 above were in conformance with the rules of the Michigan Board of Land Surveyors or by a Decree of a Court of Law; established, re-established, monumented, re-monumented, recovered, found as expressed below:

NOTE: Not more than 4 corners, all in the same town and range, may be recorded on this certificate.

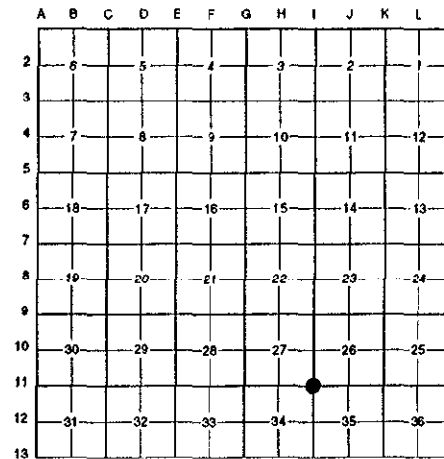

A. Description of original monument and accessories and/or subsequent restoration:

Table with 4 columns: Year, Name, Title, and Monument Type. Includes entries for Wampler, Baldwin, N/A, Gillespie, Roskelly, N/A, Stephens, and Smith.

B. Description of corner evidence found and/or method applied in restoring or reestablishing corner:

I-11 Found a 5/8" rebar on the North edge of 9 Mile Road (gravel) per L.C.R.C. L. 11381 P. 058 This corner checks the distance to I-10 per Oakland County Road Commission Alignment Plans and to I-12 per Supervisor's Eight Mile Grand River Acres Plat No. 2.
Stephens L.C.R.C. L. 11381 P. 058 (1989) Measure North 2633.09' to I-10 (G.L.O. = 2640.0') (O.C.R.C. = 2633.18')
S 40° E 38.06' - Big Nail in S.W. Side of 9" Dead Tree Measure South 2671.78' to I-12 (G.L.O. = 2640.0')
S 10° E 30.71' - Big Nail in S.W. Side of 14" Poplar Tree (Sup. Grand River Acres No. 2 = 2671.86')
S 00° W 33.00' - Steel Jacketed Monument Measure East 2630.30' to J-11 (G.L.O. = 2640.0')
S 25° W 49.22' - Nail with Tag "OHM" in N.W. Side 9" Hickory Tree
S 62° W 95.44' - Nail with Tag "OHM" in S.E. Side 20" Willow Tree
S 89° W 88.92' - P.K. Nail in South Side Detroit Edison Pole
N 14° E 44.79' - S.W. Corner of Block Bldg.

C. Description of monument for corner and accessories established to perpetuate locating the position of the corner:

I-11 Replaced the capped rebar with a 4" x 36" concrete monument and a rebar with brass cap stamped "Oakland County Remonumentation P.S. #25854."
Set PK Nail & Tag Stamped "Oakland Co. Remonumentation P.S. #25854" in SW Side 12" Poplar S 05° E 30.62'
Set PK Nail & Tag Stamped "Oakland Co. Remonumentation P.S. #25854" in NW Side 12" Hickory S 30° W 48.97'
Set PK Nail & Tag Stamped "Oakland Co. Remonumentation P.S. #25854" in SW Side 30" Willow S 67° W 95.03'
Set PK Nail & Tag Stamped "Oakland Co. Remonumentation P.S. #25854" in S Side P. Pole N 84° W 86.64'
SW Corner Block Bldg. N 19° E 45.06'
1/2" Iron Pipe N 00° E 40.08'
Steel Jacketed Mon. S 00° E 32.78'

The selected location is accepted by the Contractor and is generally accepted by professional surveyors as the best available evidence of the position of the original corner.

Signed by Randy J. Kolehouse Date 12/10/96
EARTH TECH
Surveyor's Michigan License No. 25854

