

**SURVEY & REMONUMENTATION**

MAY 22 1987  
COMMISSION

LIBER 1684800777  
LAND CORNER RECORDATION CERTIFICATE  
Filing Requirement of Act 74, Mich. P.A. 1970

Dec 18 96 305718  
\$ 7.00 MISCELLANEOUS RECORDING  
\$ 2.00 REMONUMENTATION  
18 DEC 96 1:37 P.M.  
PAID  
LYNN D. ALLEN, CLERK/REGISTER OF DEEDS  
RECEIPT# 358  
RECORDED - OAKLAND COUNTY


For corners in  
Oakland  
(County)

Located in: Farmington Corner Code #  
Township

- |                                    |   |           |   |           |             |
|------------------------------------|---|-----------|---|-----------|-------------|
| 1. Public Land Survey              | T | <u>1N</u> | R | <u>9E</u> | <u>J-11</u> |
|                                    | T |           | R |           |             |
|                                    | T |           | R |           |             |
|                                    | T |           | R |           |             |
| 2. Property Controlling in Section | S |           | T |           |             |
|                                    | S |           | T |           |             |
| 3. Miscellaneous Property in Sec.  | S |           | T |           |             |
|                                    | S |           | T |           |             |
4. Lot No. \_\_\_\_\_, Recorded Plat \_\_\_\_\_
5. Private Claims \_\_\_\_\_

Compliance with  
ACT 345, P.A. 1990  
APPROVED ON: 10-23-96  
OAKLAND COUNTY REMONUMENTATION  
PEER GROUP COMMITTEE  
Register of Deeds Stamp & File Number

I, Randy Kolehouse, in a field survey on September 2 19 96, do hereby certify that under requirements of P.A. 74 Michigan P.A. of 1970, the corner points mentioned in lines 1 and 2 above were in conformance with regulations and rules therefore as required in the current manual of survey instructions of the United States Department of the interior, Bureau of Land Management or by a decree of a Court of Law and/or that the corner points mentioned in lines 3, 4 and 5 above were in conformance with the rules of the Michigan Board of Land Surveyors or by a Decree of a Court of Law; established, re-established, monumented, re-monumented, recovered, found as expressed below:

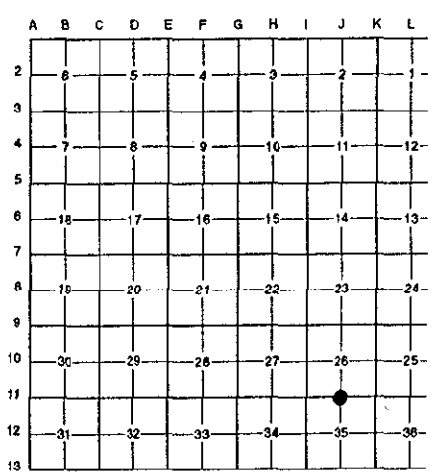

**NOTE: Not more than 4 corners, all in the same town and range, may be recorded on this certificate.**

**A. Description of original monument and accessories and/or subsequent restoration:**

J-11	1817	Wampler	G.L.O.	Set Post
	1984	Carlson	Cert. Survey	Handhole

**B. Description of corner evidence found and/or method applied in restoring or reestablishing corner:**

J-11 Found 3/8" rebar in monument box in the C/L of Tuck Road running North on the westerly extension of the C/L of 9 Mile Road running East per 1984 survey by Mason L. Brown & Son. This corner falls 0.23' East of the midpoint between I-11 and K-11.

Measure West 2630.30' to I-11 ((G.L.O. = 2618.5')  
Measure East 2629.84' to K-11 ((G.L.O. = 2618.5')

**C. Description of monument for corner and accessories established to perpetuate locating the position of the corner:**

J-11 Replaced the 3/8" rebar with a 5/8" x 24" rebar with brass cap stamped "Oakland County Remonumentation P.S. #25854" in an existing monument box.

Set PK Nail & Tag Stamped "Oakland Co. Remonumentation P.S. #25854" in SW Side DE P. Pole S 16° E 71.67'  
Set PK Nail & Tag Stamped "Oakland Co. Remonumentation P.S. #25854" in NW Side P. Pole S 31° W 83.34'  
Set PK Nail & Tag Stamped "Oakland Co. Remonumentation P.S. #25854" in S Side 14" Pine N 77° W 74.60'  
SW Corner Bldg. (Wood Beam) N 42° E 149.72'

7.00 FILE  
2.00

The selected location is accepted by the Contractor and is generally accepted by professional surveyors as the best available evidence of the position of the original corner.

Signed by Randy J. Kolehouse  
EARTH TECH

Date 12/10/96

Surveyor's Michigan License No. 25854

