

SURVEY & REMONUMENTATION

LIBER 17277 PG 707

MAR 04 1998

LAND CORNER RECORDATION CERTIFICATE Filing Requirement of Act 74, Mich. P.A. 1970

APPROVED ON: 04-16-97 JS OAKLAND COUNTY REMONUMENTATION PEER GROUP COMMITTEE ACT 345, P.A. 1990 Compliance with


For corners in SECTION

Table with columns: County (Oakland), Township (Farmington), Corner Code # (K-3), and survey details (Public Land Survey, Property Controlling, etc.)

\$ 7.00 MISCELLANEOUS RECORDING \$ 2.00 REMONUMENTATION 9 JUN 97 12:23 P.M. RECEIPT# 94A PAID RECORDED - OAKLAND COUNTY LYNN D. ALLEN, CLERK/REGISTER OF DEEDS Register of Deeds Stamp & File Number

4. Lot No. , Recorded Plat 5. Private Claims

I, Randy Kolehouse, in a field survey on April 8 19 97, do hereby certify that under requirements of P.A. 74 Michigan P.A. of 1970, the corner points mentioned in lines 1 and 2 above were in conformance with regulations and rules therefore as required in the current manual of survey instructions of the United States Department of the interior, Bureau of Land Management or by a decree of a Court of Law and/or that the corner points mentioned in lines 3, 4 and 5 above were in conformance with the rules of the Michigan Board of Land Surveyors or by a Decree of a Court of Law; established, re-established, monumented, re-monumented, recovered, found as expressed below:

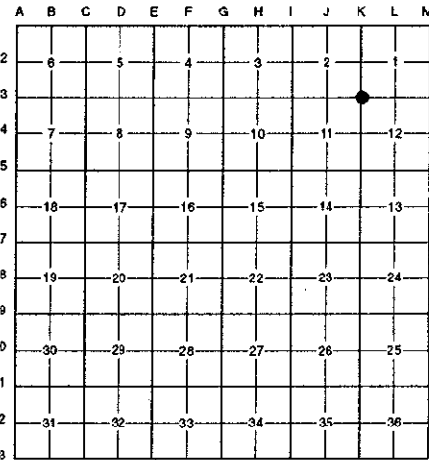

NOTE: Not more than 4 corners, all in the same town and range, may be recorded on this certificate.

A. Description of original monument and accessories and/or subsequent restoration:

Table with columns: Corner Code (K-3), Year (1817-1979), Name (Wampler, McAlpine, etc.), G.L.O. Notes, and Set Post (Set Post, Rod in Well, etc.)

B. Description of corner evidence found and/or method applied in restoring or reestablishing corner:

K-3 Found a 1/2" rebar in a monument box at the C/L intersection of 13 Mile Road (asphalt) running East and West and Middlebelt Road (asphalt). All witnesses from L.C.R.C.'s L. 7447 P. 116 and L. 7716 P. 209 have been destroyed. Checks angle at K-3 S-E (R = 89°30' (Westmont Sub. & Wood Creek Farms Sub.), M = 89°32'42"). Checks closely distances as shown in recorded plats and Oakland County tax records.

7.00 FILE 2.00 ✓


- Measure North 2648.25' to K-2 (G.L.O. = 2640.0') (O.C. Tax Maps = 2647.5 ±) Measure South 2649.03' to K-4 (G.L.O. = 2640.0') (Wood Creek Farms No. 1 = 2650.96') (Holly Hill Farms & Glenbrook Sub. = 2651.34') Measure West 2631.53' to J-3 Measure East 2655.59' to L-3 (G.L.O. = 2640.0') (Supervisor's Plat of Wood Creek Farms No. 1 = 2655.26')

C. Description of monument for corner and accessories established to perpetuate locating the position of the corner:

K-3 Placed a brass cap stamped "Oakland County Remonumentation P.S. #25854" on an existing 1/2" rebar in an existing monument box.

- PK Nail & Tag Stamped "Oakland Co. Remonumentation P.S. #25854" in SE'ly Side Signal Pole N 57° E 84.82' PK Nail & Tag Stamped "Oakland Co. Remonumentation P.S. #25854" in NE'ly Side Util. Pole S 51° E 82.59' PK Nail & Tag Stamped "Oakland Co. Remonumentation P.S. #25854" in NW Side Util. Pole S 60° W 77.40' PK Nail & Tag Stamped "Oakland Co. Remonumentation P.S. #25854" in S Side 12" Maple N 40° W 94.61' PK in Walk SE Corner 13 Mile & Middlebelt S 37° E 76.17'

The selected location is accepted by the Contractor and is generally accepted by professional surveyors as the best available evidence of the position of the original corner.

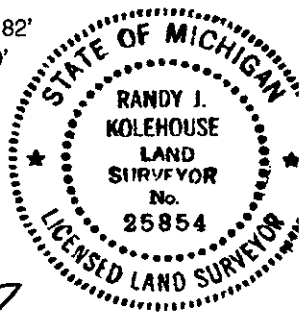

Signed by Randy J. Kolehouse Date 5/28/97 Surveyor's Michigan License No. 25854