

SURVEY & REMONUMENTATION

MAR 04 1998

LIBER 17277 PG 710

LAND CORNER RECORDATION CERTIFICATE
Filing Requirement of Act 74, Mich. P.A. 1970

Compliance with ACT 345, P.A. 1990

4-16-97 CS


APPROVED ON: OAKLAND COUNTY REMONUMENTATION PEER GROUP COMMITTEE

For corners in SECTION

Oakland (County)	Located in: Farmington Township	Corner Code #
1. Public Land Survey	T <u>1N</u> R <u>9E</u>	<u>K-6</u>
	T _____ R _____	_____
	T _____ R _____	_____
	T _____ R _____	_____
2. Property Controlling in Section	S _____ T _____ R _____	_____
	S _____ T _____ R _____	_____
3. Miscellaneous Property in Sec.	S _____ T _____ R _____	_____
	S _____ T _____ R _____	_____
4. Lot No. _____, Recorded Plat _____		
5. Private Claims _____		

\$ 7.00 MISCELLANEOUS RECORDING
\$ 2.00 REMONUMENTATION
 9 JUN 97 12:23 P.M. RECEIPT# 94A
 PAID RECORDED - OAKLAND COUNTY
 LYNN D. ALLEN, CLERK/REGISTER OF DEEDS
 Register of Deeds Stamp & File Number

I, Randy Kolehouse, in a field survey on April 9 19 97, do hereby certify that under requirements of P.A. 74 Michigan P.A. of 1970, the corner points mentioned in lines 1 and 2 above were in conformance with regulations and rules therefore as required in the current manual of survey instructions of the United States Department of the interior, Bureau of Land Management or by a decree of a Court of Law and/or that the corner points mentioned in lines 3, 4 and 5 above were in conformance with the rules of the Michigan Board of Land Surveyors or by a Decree of a Court of Law; established, re-established, monumented, re-monumented, recovered, found as expressed below:

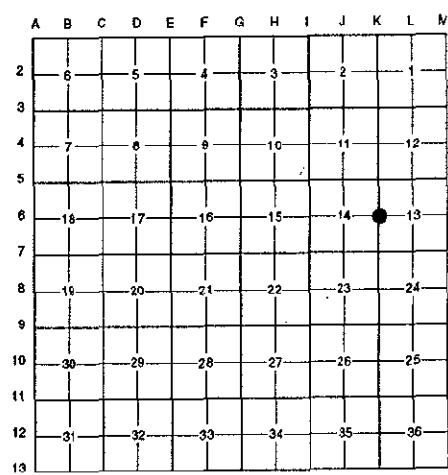

NOTE: Not more than 4 corners, all in the same town and range, may be recorded on this certificate.

A. Description of original monument and accessories and/or subsequent restoration:

K-6	1817	Wampler	G.L.O. Notes	Set Post
	1971	Carlson	L.C.R.C. L. 5883 P. 567-568	1" Iron Bar in Mon. Box
	1974	Pawlaczyk	L.C.R.C. L. 6327 P. 449-450	Round Spike in Mon. Box
	1982	O'Rourke	L.C.R.C. L. 8337 P. 138	5/8" Iron Bar in Mon. Box
	N/A	N/A	O.C. Tax Maps	N/A

B. Description of corner evidence found and/or method applied in restoring or reestablishing corner:

K-6 Found a 1/2" rebar in a monument box at the C/L of Middlebelt Road (concrete) running North and South and 31' ± South of the South end of bridge over I-696 Expressway per L.C.R.C.'s L. 6327 P. 449 and L. 8337 P. Checks closely distances as shown in recorded plats and Oakland County tax records.

L.C.R.C. L. 6327 P. 449 (1974)	L.C.R.C. L. 8337 P. 138 (1982)
NW 31.52' PK Nail at SE Cor. of CB Grate	S 88° W 19.58' Nail in Top of Wood Guard Post (m. 19.63')
	Due East 17.88' Nail in Top of Wood Guard Post (m. 17.91')
	Due North 32.56' South Edge of Conc. Bridge at C/L of Road (m. 32.62')

Measure North 2642.87' to K-5 (G.L.O. = 2640.0') (O.C. Tax Maps = 2639.54')
 Measure South 2645.55' to K-7 (G.L.O. = 2640.0') (Kimberly Sub. & Meadowbridge Condo. = 2645.65')

C. Description of monument for corner and accessories established to perpetuate locating the position of the corner:


K-6 Replaced 1/2" rebar with a 5/8" x 24" rebar with brass cap stamped "Oakland County Remonumentation P.S. #25854" in an existing monument box.

- PK Nail & Tag Stamped "Oakland Co. Remonumentation P.S. #25854" in S Side P. Pole N 86° E 24.80'
- PK Nail & Tag Stamped "Oakland Co. Remonumentation P.S. #25854" in Top Guard Rail Post S 86° E 17.91'
- PK Nail & Tag Stamped "Oakland Co. Remonumentation P.S. #25854" in E Side P. Pole (6' ± above ground) S 37° W 145.07'
- PK Nail & Tag Stamped "Oakland Co. Remonumentation P.S. #25854" in Top Guard Rail Post N 88° W 19.63'
- Chiseled "+" S End E Guard Wall for Bridge N 42° E 29.18'
- Chiseled "+" S End W Guard Wall for Bridge N 16° W 43.00'
- SW Corner Square C.B. N 17° W 31.19'

7 N FILE
20

The selected location is accepted by the Contractor and is generally accepted by professional surveyors as the best available evidence of the position of the original corner.

Signed by Randy J. Kolehouse Date 5/20/97
 EARTH TECH

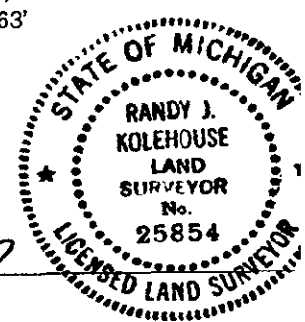

Surveyor's Michigan License No. 25854