SURVEY & REMONUMENTATION

MAY 2 2 1997

For corners in COMMISSION

Oakland (County)

DEC 18 96 3 05737

LIBER 16848 PG 797

$ 7.00 MISCELLANEOUS RECORDING
$ 2.00 REMONUMENTATION
18 DEC 96 1:40 P.M. RECEIPT# 358
PAID RECORDED - OAKLAND COUNTY
LYNN D. ALLEN, CLERK/REGISTER OF DEEDS

LAND CORNER RECORDATION CERTIFICATE

Filing Requirement of Act 74, Mich. P.A. 1970

Located in: Farmington Township Corner Code #

Compliance with ACT 345, P.A. 1990

APPROVED ON: 10-29-96 TS
OAKLAND COUNTY REMONUMENTATION PEER GROUP COMMITTEE

Register of Deeds Stamp & File Number

1. Public Land Survey T 1N R 9E K-12
   T ____ R ____
   T ____ R ____
   T ____ R ____
2. Property Controlling S ____ T ____ R ____
   in Section S ____ T ____ R ____
3. Miscellaneous S ____ T ____ R ____
   Property in Sec. S ____ T ____ R ____

4. Lot No. ____, Recorded Plat ____
5. Private Claims ____

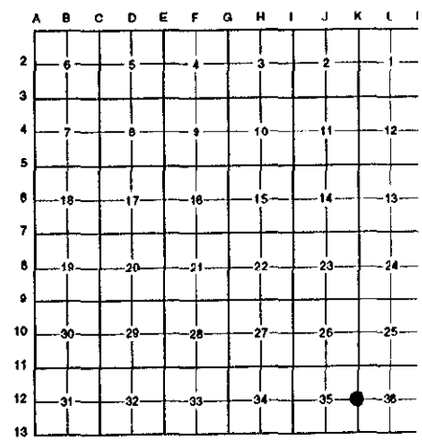

I, Randy Kolehouse, in a field survey on August 5 19 96, do hereby certify that under requirements of P.A. 74 Michigan P.A. of 1970, the corner points mentioned in lines 1 and 2 above were in conformance with regulations and rules therefore as required in the current manual of survey instructions of the United States Department of the interior, Bureau of Land Management or by a decree of a Court of Law and/or that the corner points mentioned in lines 3, 4 and 5 above were in conformance with the rules of the Michigan Board of Land Surveyors or by a Decree of a Court of Law; established, re-established, monumented, re-monumented, recovered, found as expressed below:

NOTE: Not more than 4 corners, all in the same town and range, may be recorded on this certificate.

A. Description of original monument and accessories and/or subsequent restoration:

K-12	1817	Wampler	G.L.O.	Set Post
	1890	Russell	Survey	N/A
	1919	N/A	Richland Gardens Sub.	N/A

B. Description of corner evidence found and/or method applied in restoring or reestablishing corner:

K-12 Found no information on record showing usage of this corner. Checked with MDOT for Road Plans on Grand River Drive which had no tie to this corner. Oakland County Tax Maps show K-12 on C/L of Independence Road running East and the C/L of Middle Belt Road running North and South which seems to check Richland Gardens Sub. although no corner is shown in said subdivision. Set a point on the C/L of Independence Road (50' wide) using irons found along North and South right-of-way line and the C/L joint of Middle Belt Road. *This point is on a straight line between K-13 and K-11.*

Measure South 2638.71' to K-13 (G.L.O. = 2640.0')
Measure North 2666.94' to K-11 (G.L.O. = 2640.0') (Calc. from Assessor's Richland State Sub. = 2671.4')

700 FILE
2 w

C. Description of monument for corner and accessories established to perpetuate locating the position of the corner:

K-12 Set a 5/8" x 24" iron bar with a brass cap stamped "Oakland County Remonumentation P.S. #25854." Also set a monument box.

Set PK Nail & Tag Stamped "Oakland Co. Remonumentation P.S. #25854" in SW Side P. Pole N 40° W 38.94'
Set PK Nail & Tag Stamped "Oakland Co. Remonumentation P.S. #25854" in S Side P. Pole N 80° E 70.20'
Set PK Nail & Tag Stamped "Oakland Co. Remonumentation P.S. #25854" in Top of 4"x4" Wood Retaining Wall S 54° E 38.24'
Set PK Nail & Tag Stamped "Oakland Co. Remonumentation P.S. #25854" in NW Side P. Pole S 30° W 69.58'

The selected location is accepted by the Contractor and is generally accepted by professional surveyors as the best available evidence of the position of the original corner.

Signed by Randy J. Kolehouse Date 12/13/96
EARTH TECH
Surveyor's Michigan License No. 25854

STATE OF MICHIGAN
RANDY J. KOLEHOUSE
LAND SURVEYOR
No. 25854
LICENSED LAND SURVEYOR

FORM APPROVED BY MICHIGAN STATE BOARD OF LAND SURVEYORS, JAN. 28, 19
REVISED MAY 14, 19
REVISED JAN., 19