

**SURVEY & REMONUMENTATION**

MAY 22 1997

**COMMISSION**

LIBER 16848 PG 784

Dec 18 96 305725

\$ 7.00 MISCELLANEOUS RECORDING

\$ 2.00 REMONUMENTATION

18 DEC 96 1:38 P.M.

RECEIPT# 358

PAID

RECORDED - OAKLAND COUNTY

LYNN D. ALLEN, CLERK/REGISTER OF DEEDS

**LAND CORNER RECORDATION CERTIFICATE**  
Filing Requirement of Act 74, Mich. P.A. 1970

For corners in

Oakland  
(County)

Located in: Farmington Corner Code #  
Township


1. Public Land Survey	T	<u>1N</u>	R	<u>9E</u>	<u>K-13</u>
	T	_____	R	_____	_____
	T	_____	R	_____	_____
	T	_____	R	_____	_____
2. Property Controlling in Section	S	_____	T	_____	_____
	S	_____	T	_____	_____
3. Miscellaneous Property in Sec.	S	_____	T	_____	_____
	S	_____	T	_____	_____

Compliance with ACT 345, P.A. 1990  
APPROVED ON: 10-29-96 TJ  
OAKLAND COUNTY REMONUMENTATION PEER GROUP COMMITTEE  
Register of Deeds Stamp & File Number

4. Lot No. \_\_\_\_\_, Recorded Plat \_\_\_\_\_  
5. Private Claims \_\_\_\_\_

I, Randy Kolehouse, in a field survey on September 2 19 96, do hereby certify that under requirements of P.A. 74 Michigan P.A. of 1970, the corner points mentioned in lines 1 and 2 above were in conformance with regulations and rules therefore as required in the current manual of survey instructions of the United States Department of the interior, Bureau of Land Management or by a decree of a Court of Law and/or that the corner points mentioned in lines 3, 4 and 5 above were in conformance with the rules of the Michigan Board of Land Surveyors or by a Decree of a Court of Law; established, re-established, monumented, re-monumented, recovered, found as expressed below:

**NOTE: Not more than 4 corners, all in the same town and range, may be recorded on this certificate.**

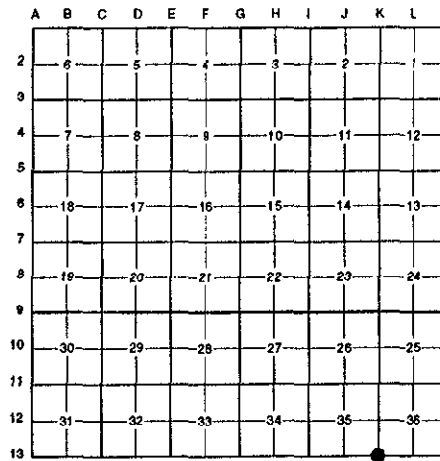

**A. Description of original monument and accessories and/or subsequent restoration:**

K-13	1817	Wampler	G.L.O.	Set Post
	1890	Russell	County Surveyor	N/A
	1917	N/A	Brookside Park Sub. L. 19 P. 4	N/A
	1980	Parish	L.C.R.C. L. 7839 P. 523	Conc. Monument in Monument Box

Records indicate the corner is not common with K-1, T1S, R9E.

**B. Description of corner evidence found and/or method applied in restoring or reestablishing corner:**

K-13 Found a concrete monument in a monument box at the C/L of 8 Mile Road running East and West on the C/L of Middle Belt Road (extended South) running North 91.72' East of the monument box at K-1, T1S, R9E, per L.C.R.C. L. 7839 P. 523. Checks closely the distance West to J-13 per Brookside Park Sub. L. 19 P. 4 (1917).

L.C.R.C. L. 7839 P. 523 (1980)  
N. 20° E. 55.00' Tag #350 in E. face of guy pole  
S. 60° E. 44.65' N.W. corner of catch basin rim  
West 91.72' Centerline found mon. box. (N.W. Cor. of Sec. 1, T1S., R.9E)

Measure East 2627.26' to L-13 (G.L.O. = 2640.0')  
Measure West 2630.94' to J-13 (G.L.O. = 2640.0') (Brookside Park Sub. = 2633.0')  
Measure North 2638.71' to K-12 (G.L.O. = 2640.0')

**C. Description of monument for corner and accessories established to perpetuate locating the position of the corner:**

K-13 Set a brass cap stamped "Oakland County Remonumentation P.S. #25854" on the existing concrete monument in an existing monument box.

Set PK Nail & Tag Stamped "Oakland Co. Remonumentation P.S. #25854" in SW Side Util. Pole N 53° W 100.88'  
Set PK Nail & Tag Stamped "Oakland Co. Remonumentation P.S. #25854" in NW Side Util. Pole N 34° E 55.92'  
C/L Manhole N 10° E 29.8'  
NW Cor. Sq. CB S 48° E 44.88'  
C/L top Hydrant S 68° W 127.02'  
C/L Monument Box NW Cor., T1S, R9E, N 87° W 91.82'

The selected location is accepted by the Contractor and is generally accepted by professional surveyors as the best available evidence of the position of the original corner.

Signed by Randy Kolehouse Date 12/10/96  
EARTH TECH  
Surveyor's Michigan License No. 25854

